

Service No.

San Malt

Address # 490 WALTHAM ST.

490 Waltham Street Location

Kind of Pipe PVC, CI Size 6", 4" Size of Main 8


Repair—Renewal—(New Service) Scire #0626 Location

Date	Material	Amount	Total	Date	Amount
7/9 92	8 LF 4" C.I.			1-7-92	\$200.00
	70 LF 6" PVC				
	22° BEND				
	4" x 6" FERRO				
	6" x 6" FERRO				
May '66	6" Transit @ 500		\$200.00		

DATE 7/9/92

TOWN OF LEXINGTON — BOARD OF PUBLIC WORKS
SEWER DIVISION

Sketch of Service Here **490**

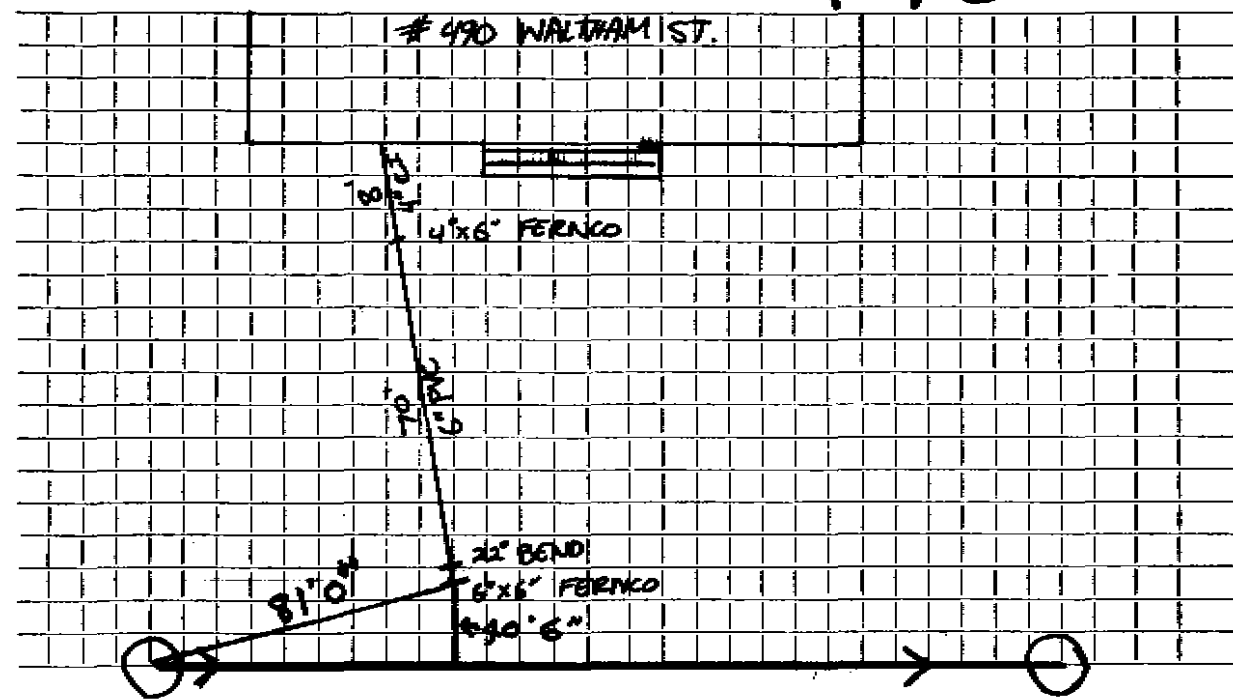

Connection made in Street. Work completed

Remarks: INSTALLED BY: SCIRE
INSPECTED BY: C. GALJAARD