


DATE 2/21/90

TOWN OF LEXINGTON — BOARD OF PUBLIC WORKS
SEWER DIVISION

Sketch of Service Here **942**

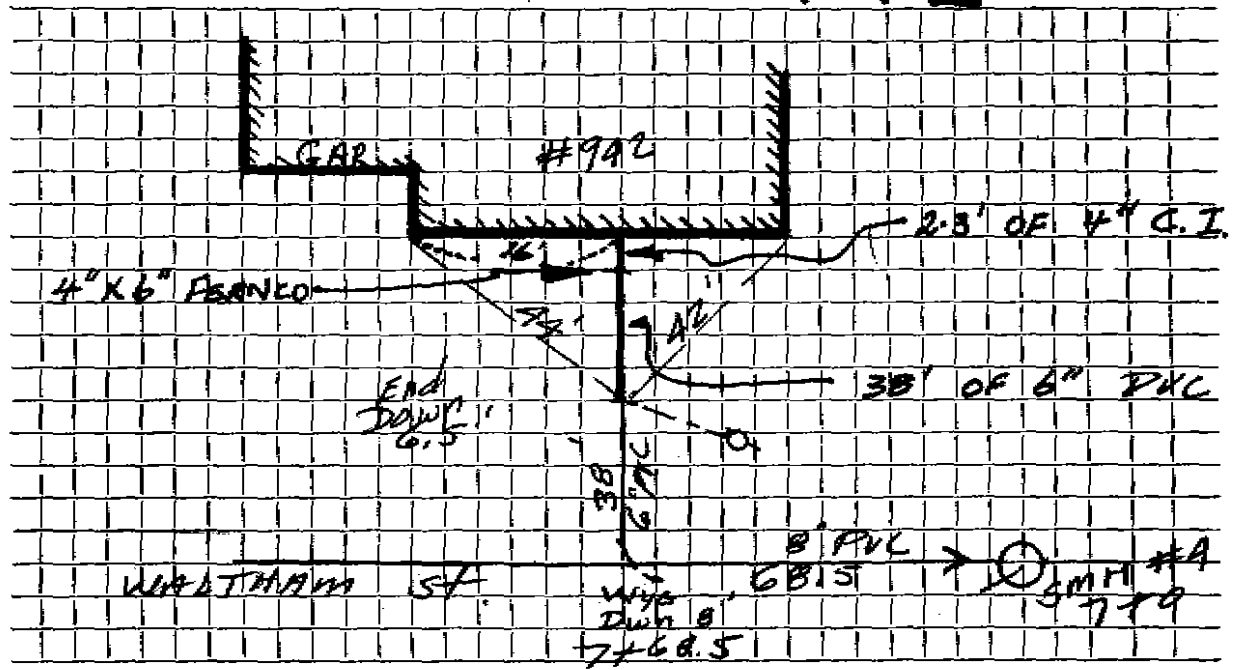

Connection made in WALTHAM Street. Work completed

Remarks:
.....
.....