


DATE _____

TOWN OF LEXINGTON — BOARD OF PUBLIC WORKS

SEWER DIVISION

Sketch of Service Here

495

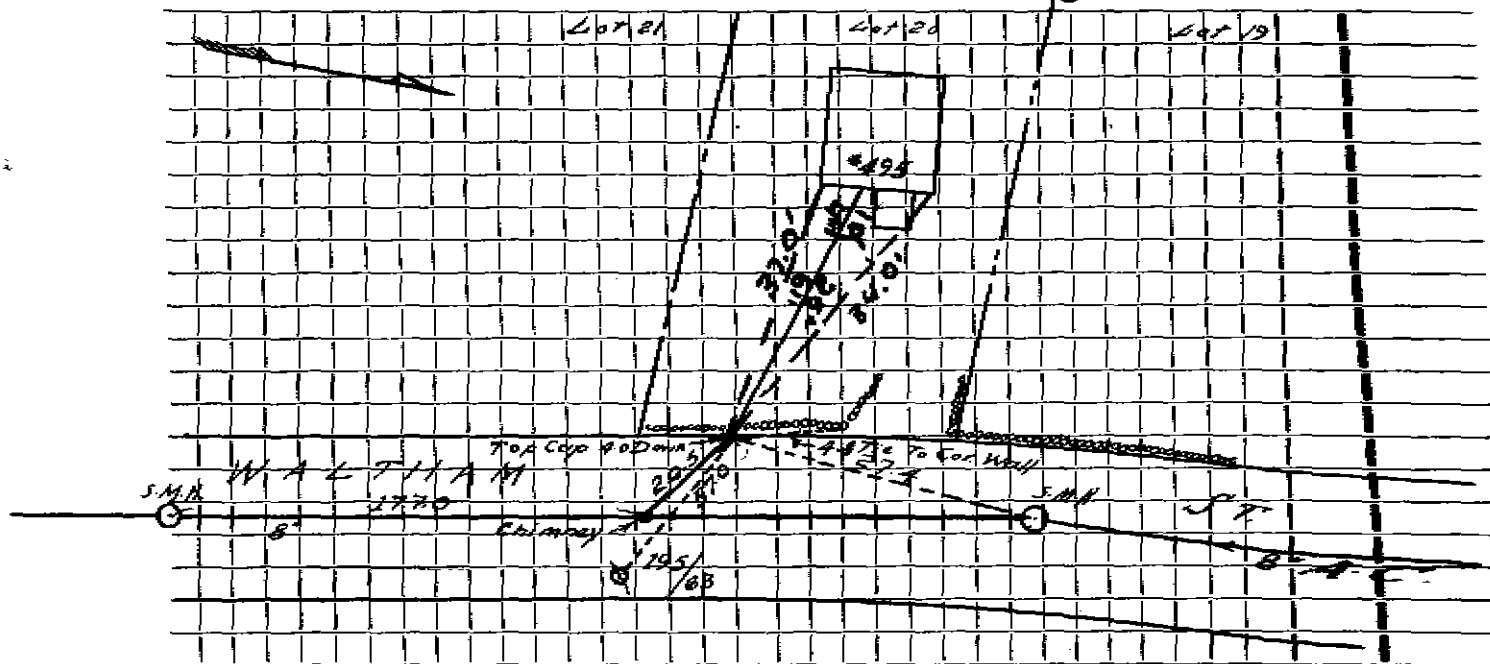

Connection made in 495 WALTHAM Street.

Work completed 4/24/75

Remarks:

.....

.....