

Service No.

Name

Address

501 Walnut Street Lot 21

Location

Size 6"

Kind of Pipe

Size of Main 8"

Location


Repair—Renewal—New Service

| Date | Material | Amount | Total | Date | Amount |
|--------|------------------------|--------|--------|------|--------|
| 66 221 | 6" Transite pipe @5.00 | | 112.50 | | |
| | | | | | |
| | | | | | |
DATE _____

TOWN OF LEXINGTON — BOARD OF PUBLIC WORKS
SEWER DIVISION

Sketch of Service Here

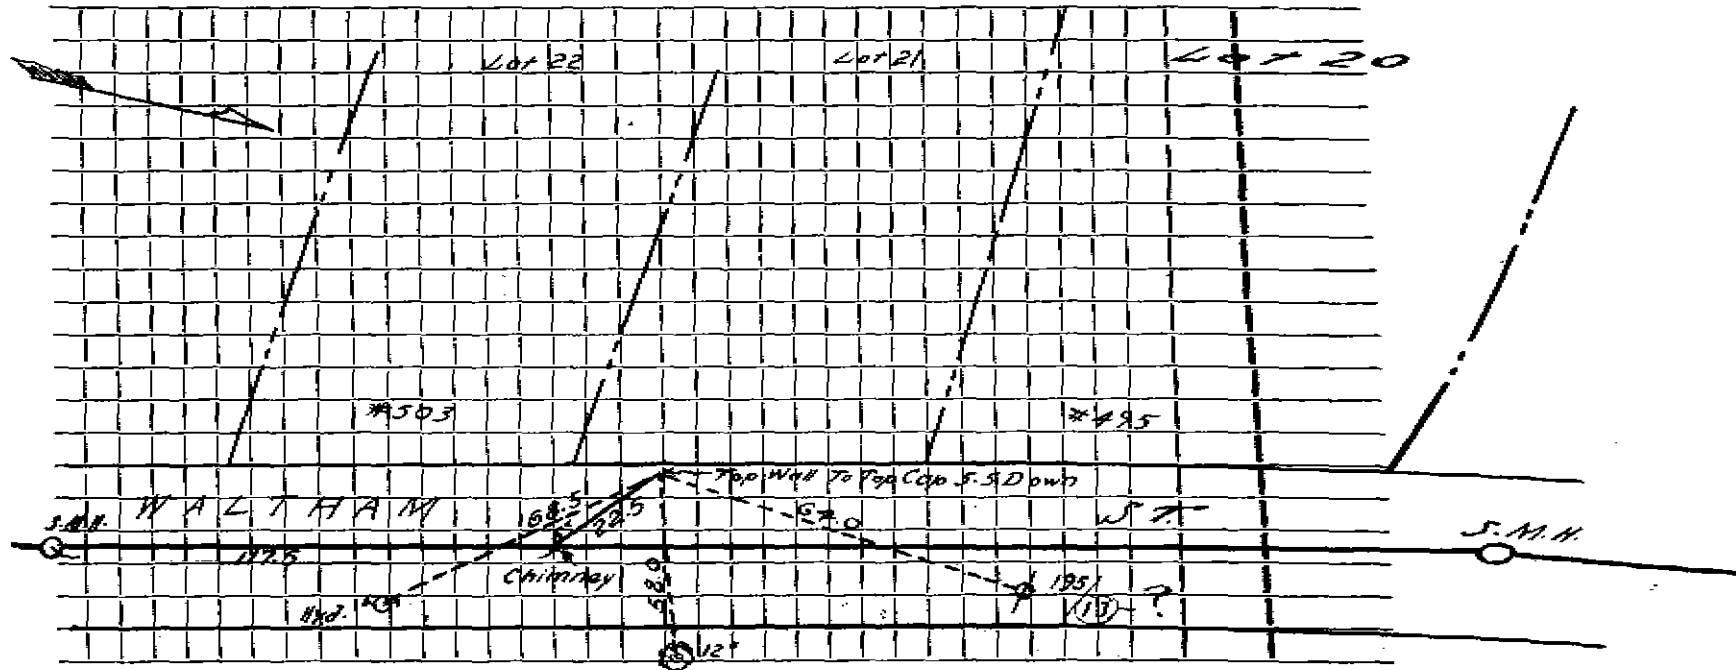

Connection made in Street. Work completed

Remarks:
.....
.....