




SEWER DIVISION

Sketch of Service Here

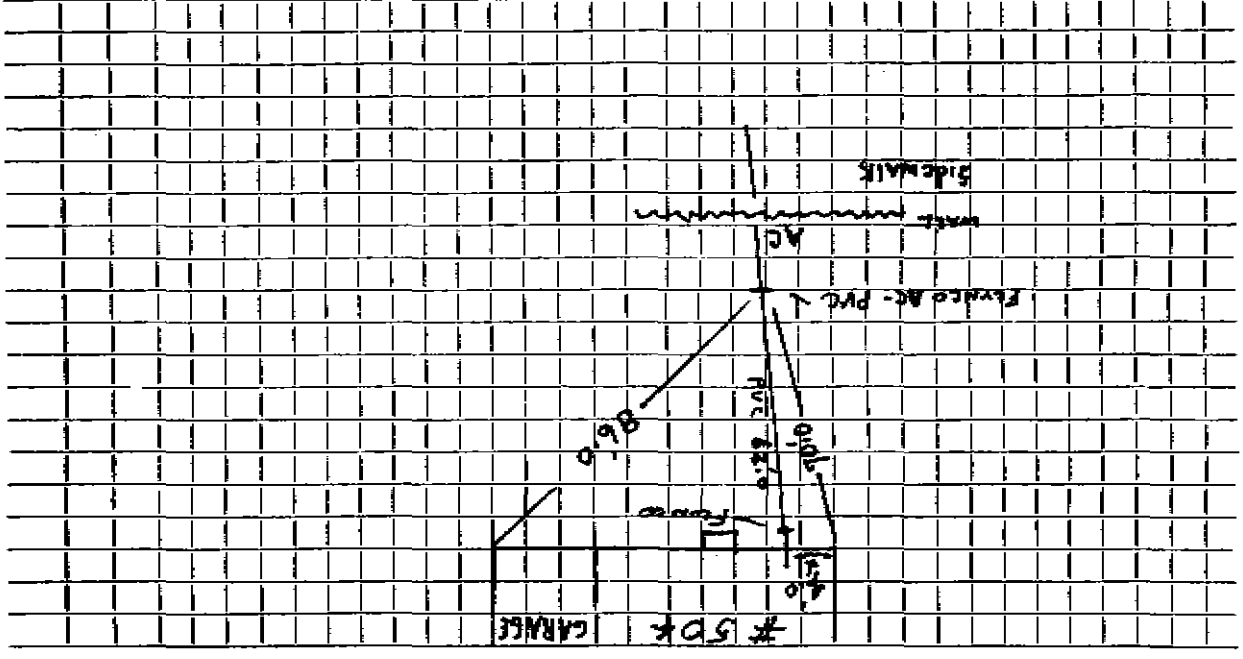

Connection made in \_\_\_\_\_ Street. Work completed \_\_\_\_\_  
Remarks: \_\_\_\_\_

Name Joseph Grinnell

Service No. 68

Address # 504 Waltham St Lot 133 A

504 Waltham Street Location

Kind of Pipe

Size 6"

Size of Main 8"

Repair—Renewal—New Service Lexington Sewerage #1634

Location JUL 26 1971

Date	Material	Amount	Total	Date	Amount
166	37 1/2' 6" Transite pipe @5.00		187.50	3-17-76	187.50
22-70	34' 6" Transite pipe				
27	40' 6" Cast Iron pipe				


DATE \_\_\_\_\_

TOWN OF LEXINGTON — BOARD OF PUBLIC WORKS

SEWER DIVISION

Sketch of Service Here

504

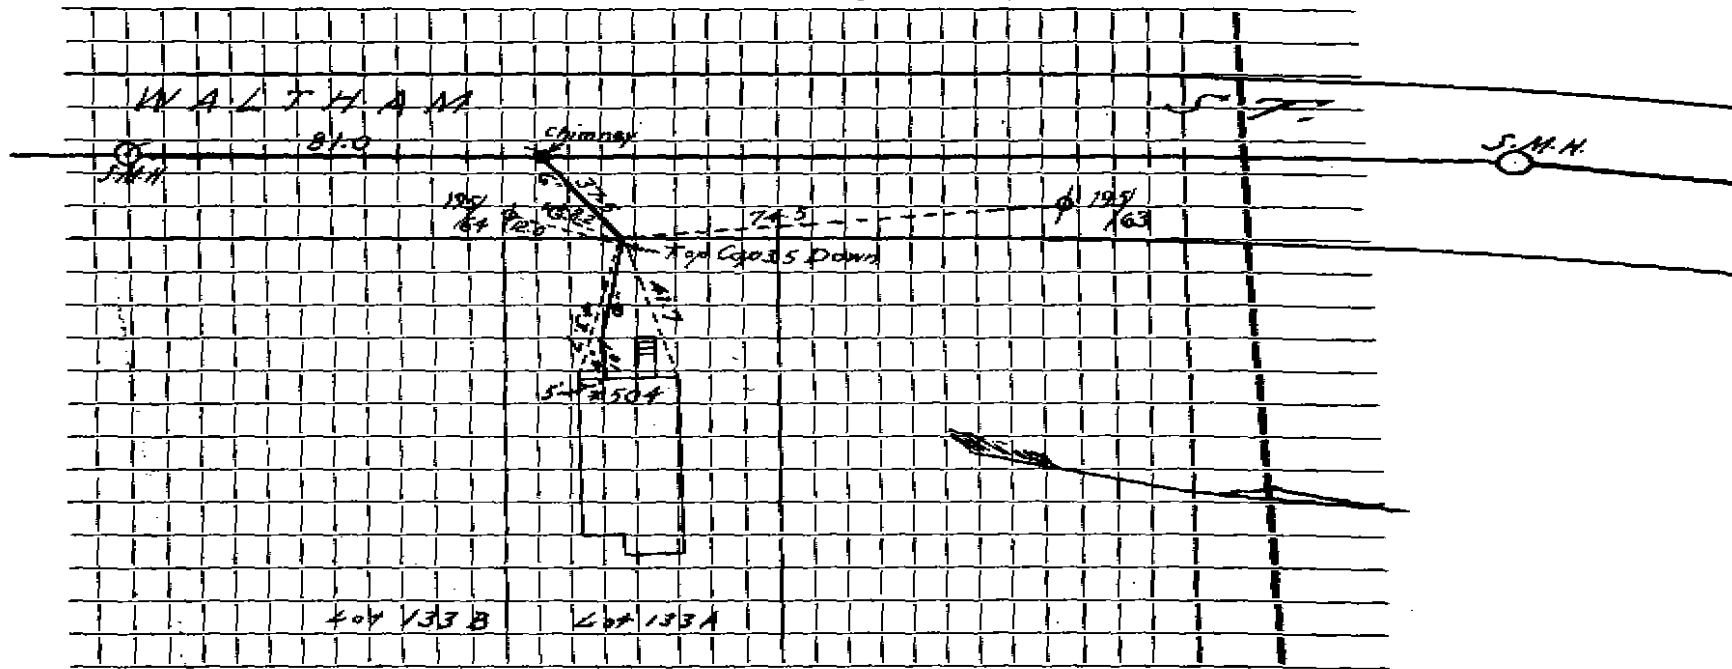

Connection made in ..... Street. Work completed .....

Remarks: .....

.....

.....