

Name

Service No.

Address 506 Waltham St Lot 133

506 WALTHAM STREET

Location

Kind of Pipe

Size 6"

Size of Main 8"

Repair—~~Renewal~~—New Service

Location


Date		Material	Amount	Total	Date		Amount
'66	39'	6" Transite pipe @5.00		195.00			

DATE _____

TOWN OF LEXINGTON — BOARD OF PUBLIC WORKS

SEWER DIVISION

Sketch of Service Here

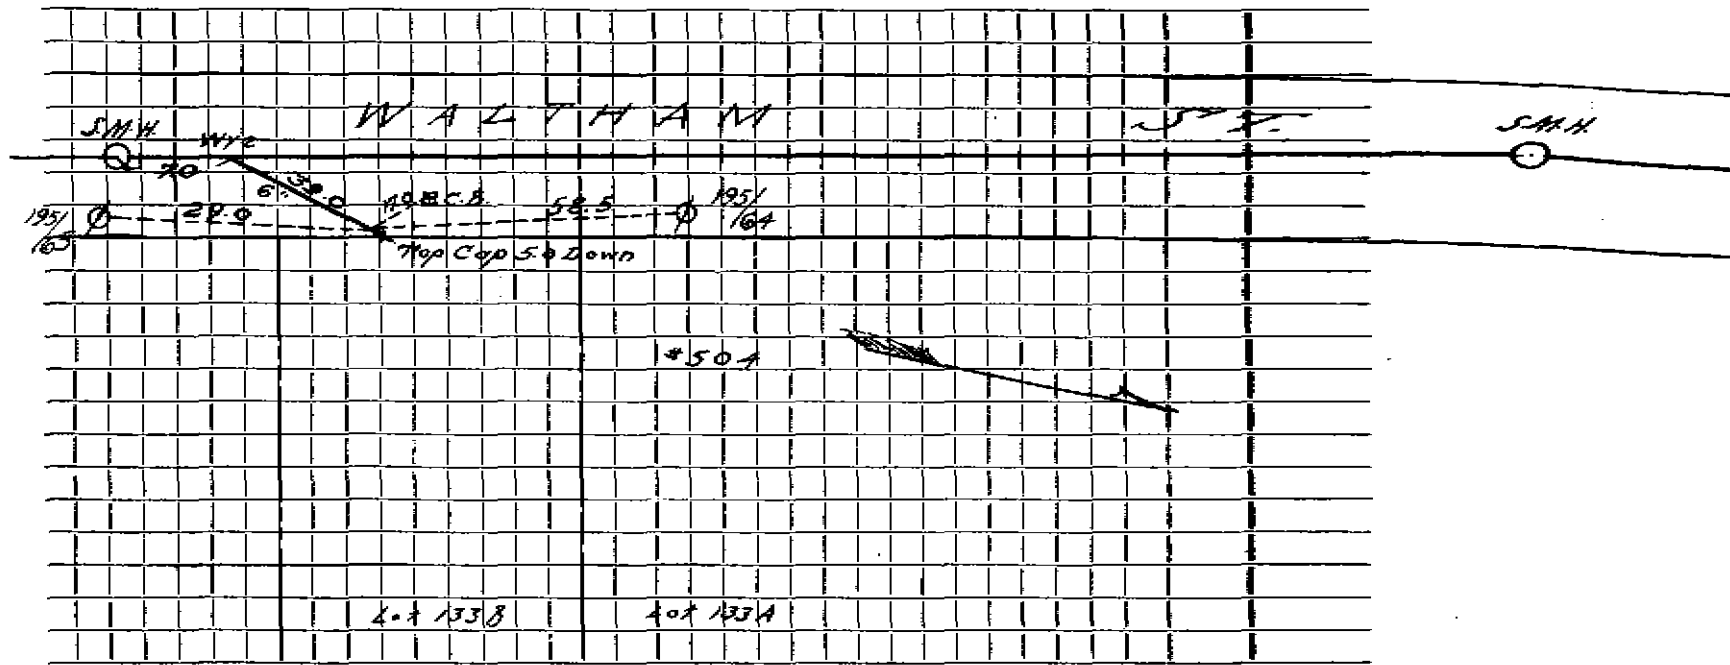

Connection made in Street. Work completed

Remarks:
.....
.....