


DATE _____

TOWN OF LEXINGTON — BOARD OF PUBLIC WORKS

SEWER DIVISION

Sketch of Service Here **52**

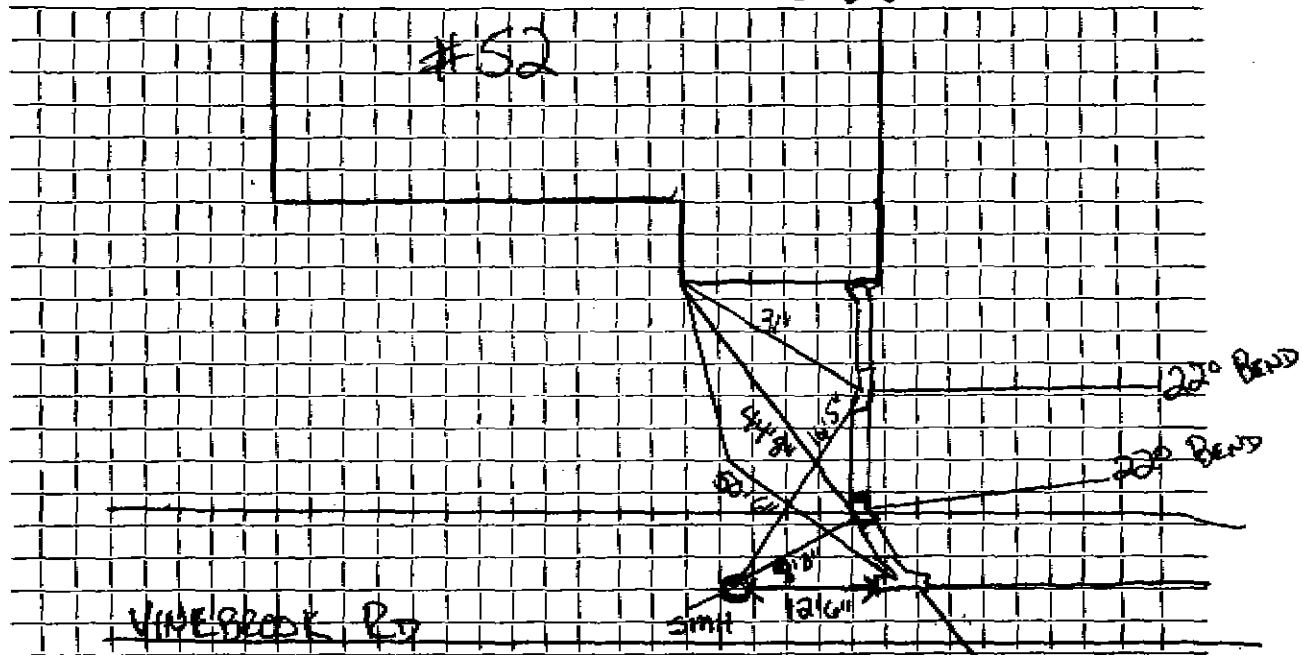

Connection made in Street.

Work completed

6" PVC WYE two 6" PVC to Clay FERNCO'S

Remarks: Original Service 8-6-29