


DATE _____

TOWN OF LEXINGTON — BOARD OF PUBLIC WORKS SEWER DIVISION

Sketch of Service Here **520**

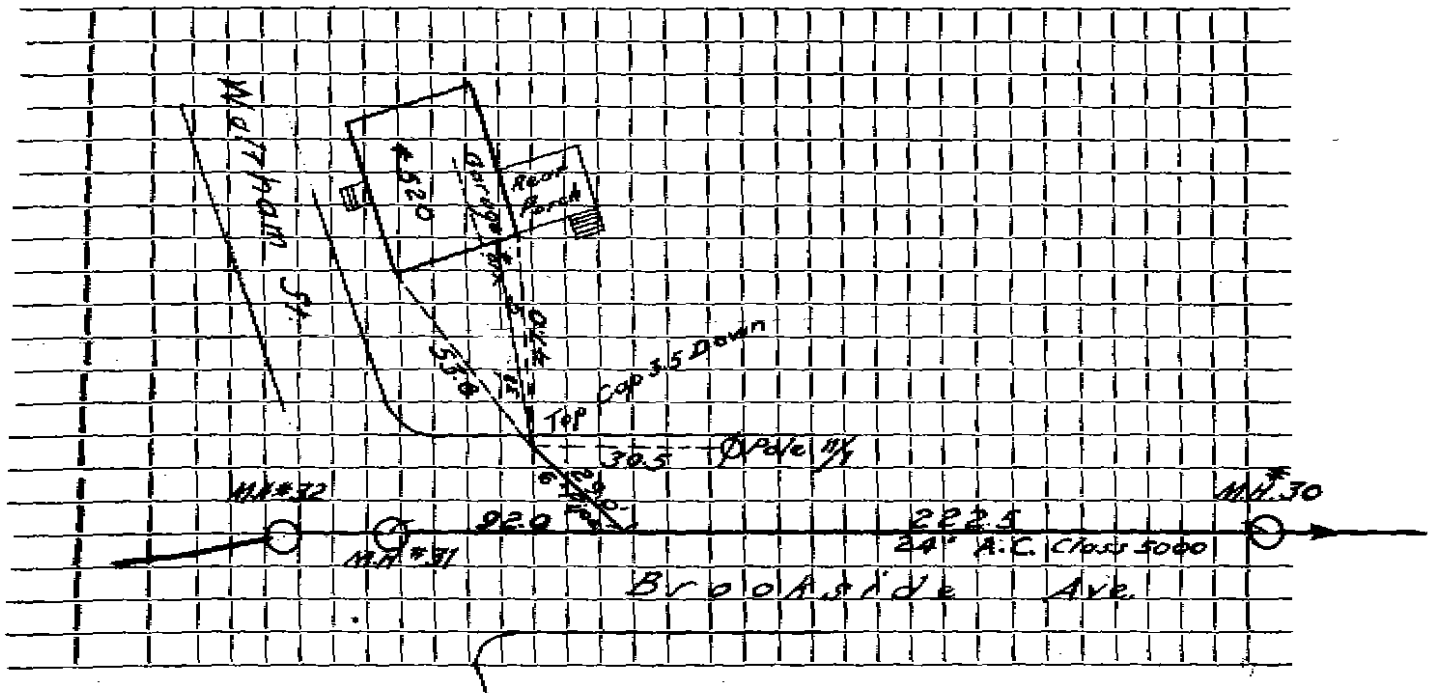

action made in _____ Street. Work completed _____

marks: _____
