




DATE \_\_\_\_\_

TOWN OF LEXINGTON — BOARD OF PUBLIC WORKS  
SEWER DIVISION

Sketch of Service Here

608

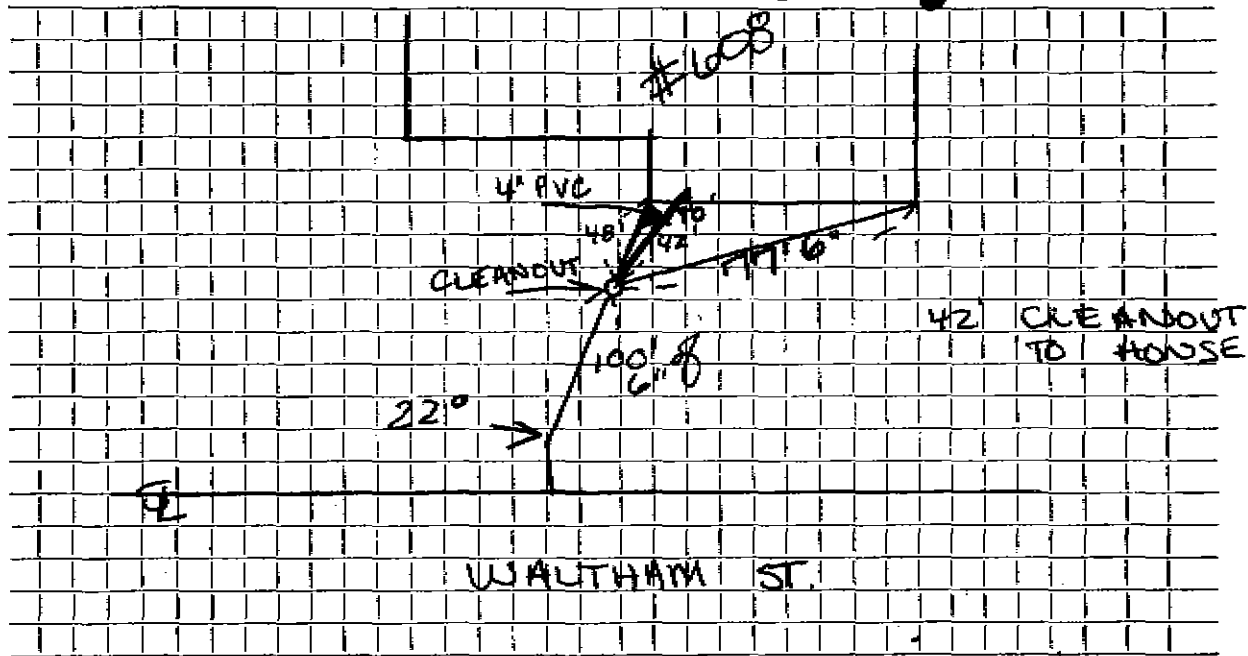

Connection made in WALTHAM ST. Street. Work completed .....

Remarks: NOTE: NO OUTSIDE TIES .....