


DATE 9-13-90

TOWN OF LEXINGTON — BOARD OF PUBLIC WORKS
SEWER DIVISION

Sketch of Service Here **610**

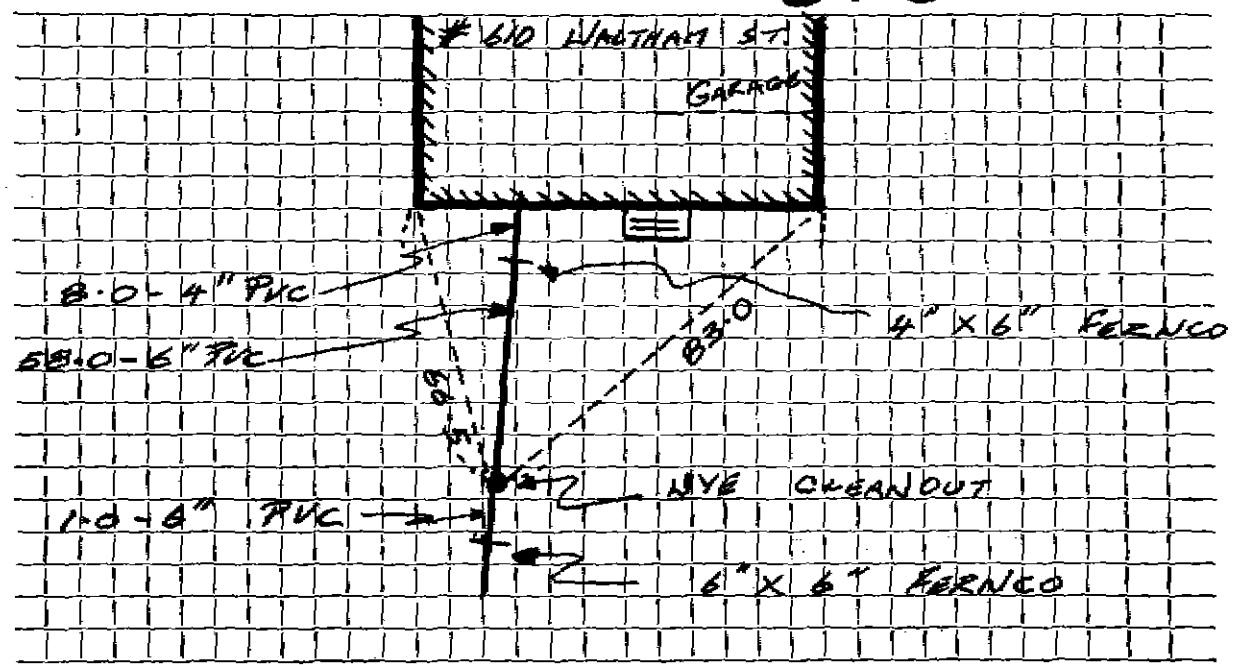

Connection made in WALTHAM Street. Work completed

Remarks: