

Name John H. Bales

Service No. 19

Address #624 WALTHAM ST.

624 WALTHAM STREET Location

Kind of Pipe AC

Size 6"

Size of Main 8"

Remarks New Service ARIEX #3979

Location AUG 26 1986

Date	Material	Amount	Total	Date	Amount
5-13	77	32'-6" AC @ \$10.00	\$320.00	6/17/85	Deposit
5/26/85	45'	6" PVC			
	2	45° Bends			
	2	22° Bends			
	1	4" x 6" DONUT			
		AC TO PVC ADPT.			


DATE \_\_\_\_\_

TOWN OF LEXINGTON — BOARD OF PUBLIC WORKS

SEWER DIVISION

Sketch of Service Here

624 624

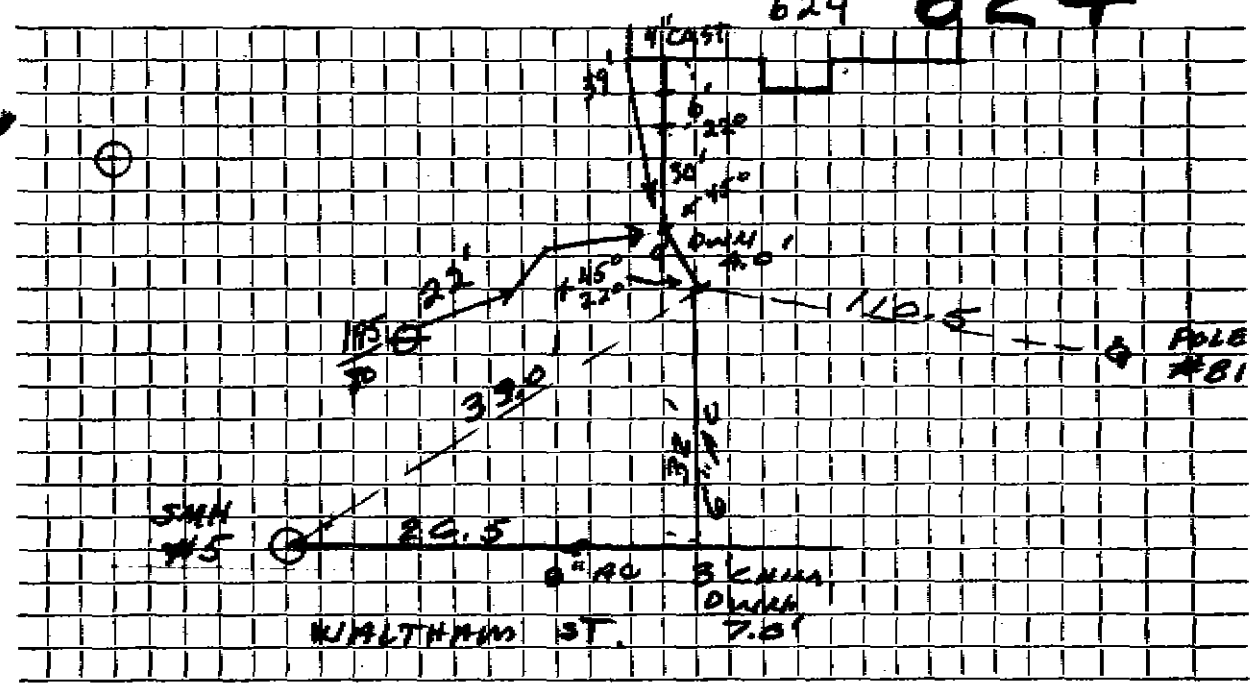

Connection made in ..... Street.      Work completed .....

Remarks: .....  
.....  
.....