


DATE JUNE 13, 1977

TOWN OF LEXINGTON — BOARD OF PUBLIC WORKS
SEWER DIVISION

Sketch of Service Here **634**

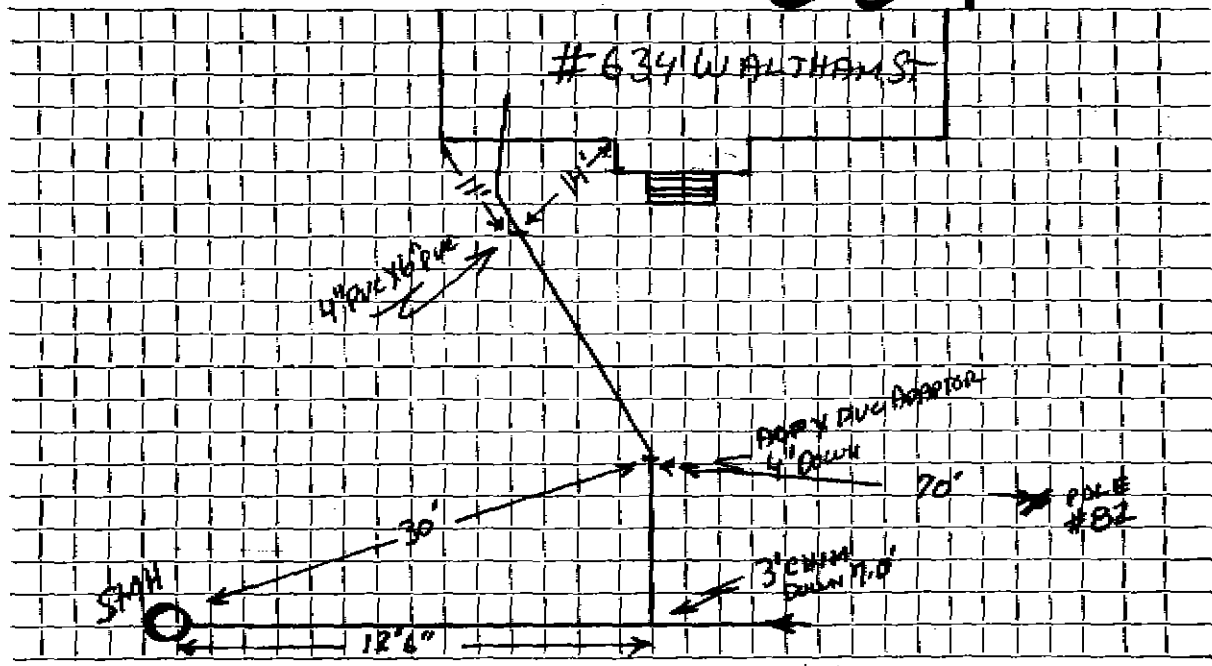

Connection made in WALTHAM ST Street. Work completed JUNE 12, 1984

Remarks:

.....

.....