

Service No.

Name Catalano

Address 643 WALTHAM ST.

643 Waltham Street

Location

Kind of Pipe

Size 6"

Size of Main 8"

Repair—Renewal—New Service

B & B Landscaping #0155

Location

Date	Material	Amount	Total	Date	Amount
11-17-77	6" OYE CLEANOUT			11-18-77	320.00
6/17/77	13 LF 6" PVC		\$320.00		
	32' 6" A.C. @ \$10.00				

Paid

DATE _____


TOWN OF LEXINGTON — BOARD OF PUBLIC WORKS

SEWER DIVISION

#643 WALTHAM ST

Sketch of Service Here

643

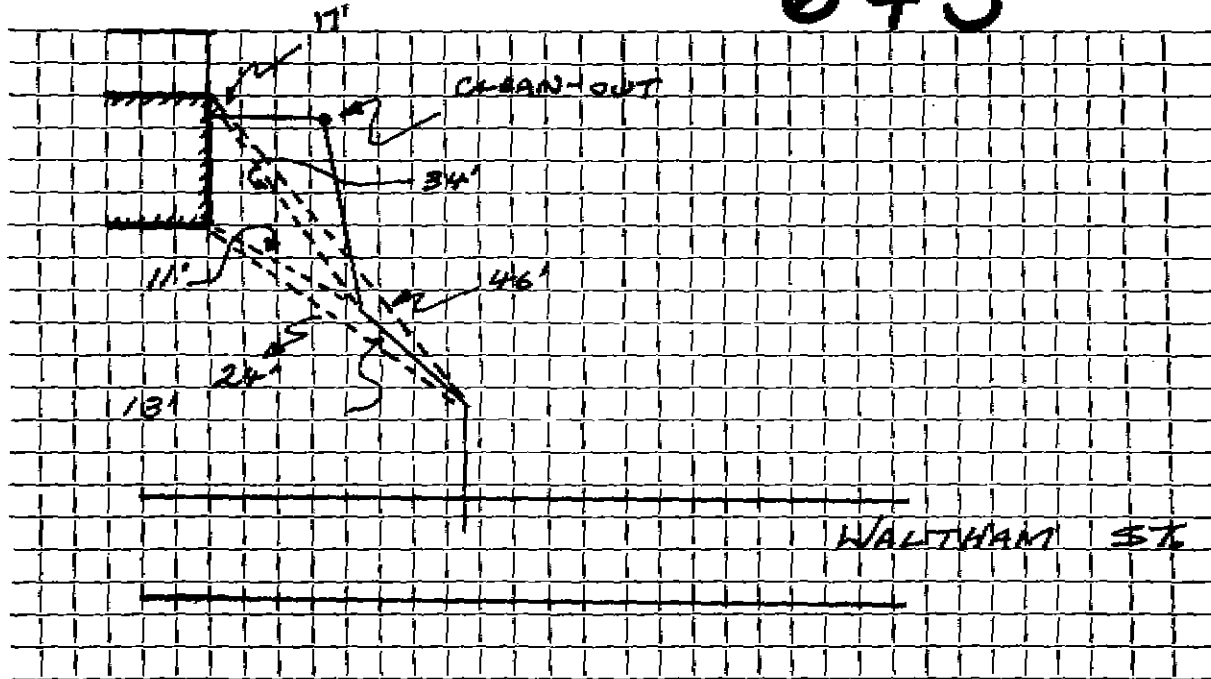

Connection made in WALTHAM Street. Work completed

Remarks:
.....
.....