

Service No. 108

Mr. & Mrs. Armando Mancini

Address # 673 WALTHAM ST.

673 Waltham Street Location

Kind of Pipe AC Size 6" Size of Main 8"

Repair—Renewal—New Service Anthony Griecci Construction Co. #3196 Location FEB 13 1978

Date	Material	Amount	Total	Date	Location	Amount
2-7	27 31' - C'ac @	110.00	1310.00	12-1-78	Papase J	210.00
2/12/78	25' - C'ac 8' of 4" EI					


DATE _____

TOWN OF LEXINGTON — BOARD OF PUBLIC WORKS

SEWER DIVISION

Sketch of Service Here

673

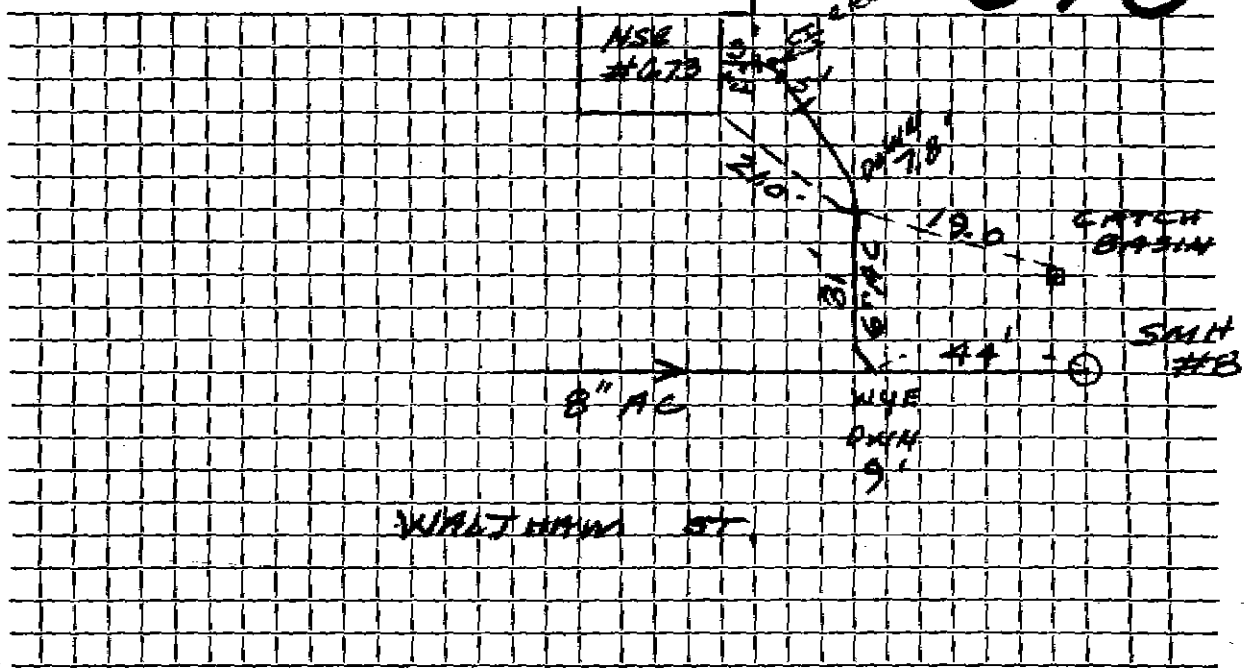

Connection made in Waltham Street. Work completed

Remarks:
.....
.....