

Name

Service No.

Address **675 WALTHAM ST.**

**STONEY MEADOW DRIVING RANGE**

Location

Kind of Pipe

Size **6" x 8"**

Size of Main **8"**


Repair—Renewal—New Service **NEW SERVICE**

Location

Date	Material	Amount	Total	Date	Amount
6/15	94 386' of PVC				
	1-4" x 6" REDUCER				
	16' of 4" PVC				
				4.17.00	Service Blocked 234 up
					papers + solids - pipe has
					flat spot

DATE 6/15/94

TOWN OF LEXINGTON — BOARD OF PUBLIC WORKS  
SEWER DIVISION

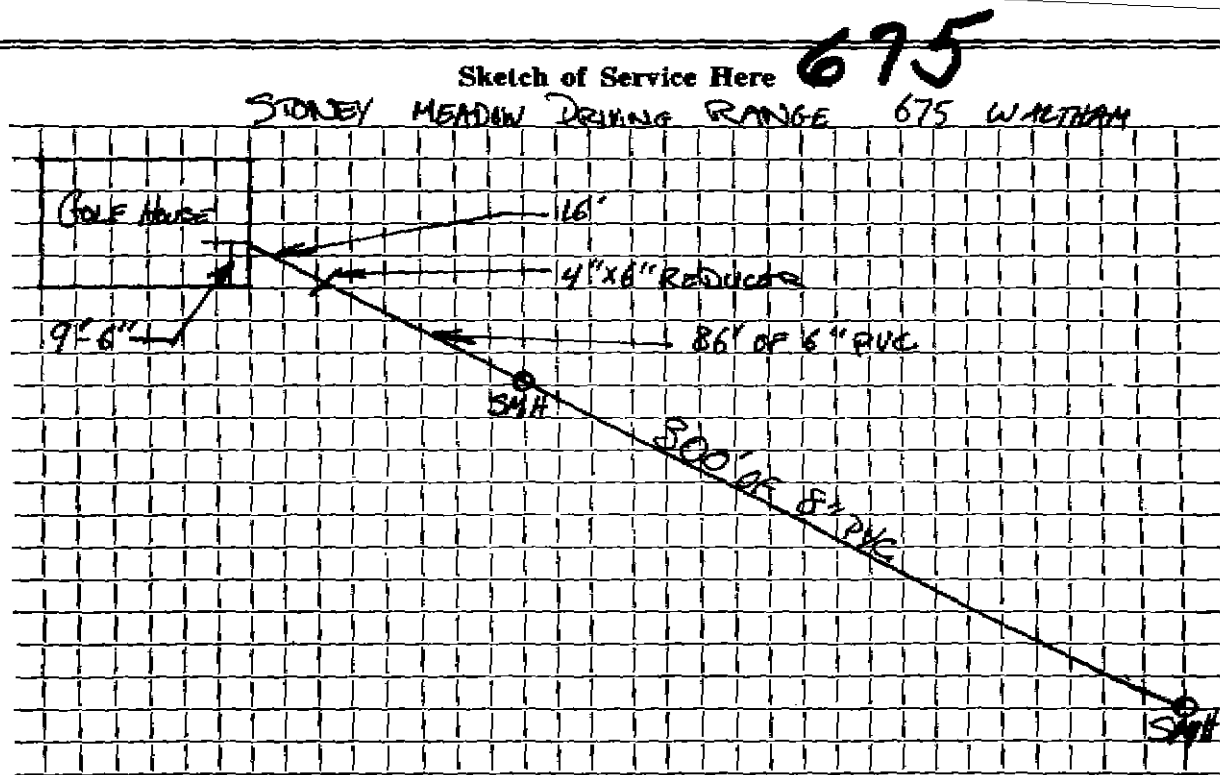

Connection made in ..... Street. Work completed .....

Remarks: .....  
.....  
.....