

Name

Service No.

Address 72 Waltham ST

72 Waltham STREET

Location

Kind of Pipe PVC

Size 6"

Size of Main 6" clay

Repair—Renewal—(New Service)


Location

Date	Material	Amount	Total	Date	Amount
12/11/90	47' 6" PVC Pipe				
	1 4 x 6 PVC Fernco				
	2 6" CI PVC				
	1 6 x 6 x 6 Mye				

DATE \_\_\_\_\_

TOWN OF LEXINGTON — BOARD OF PUBLIC WORKS  
SEWER DIVISION

Sketch of Service Here **72**

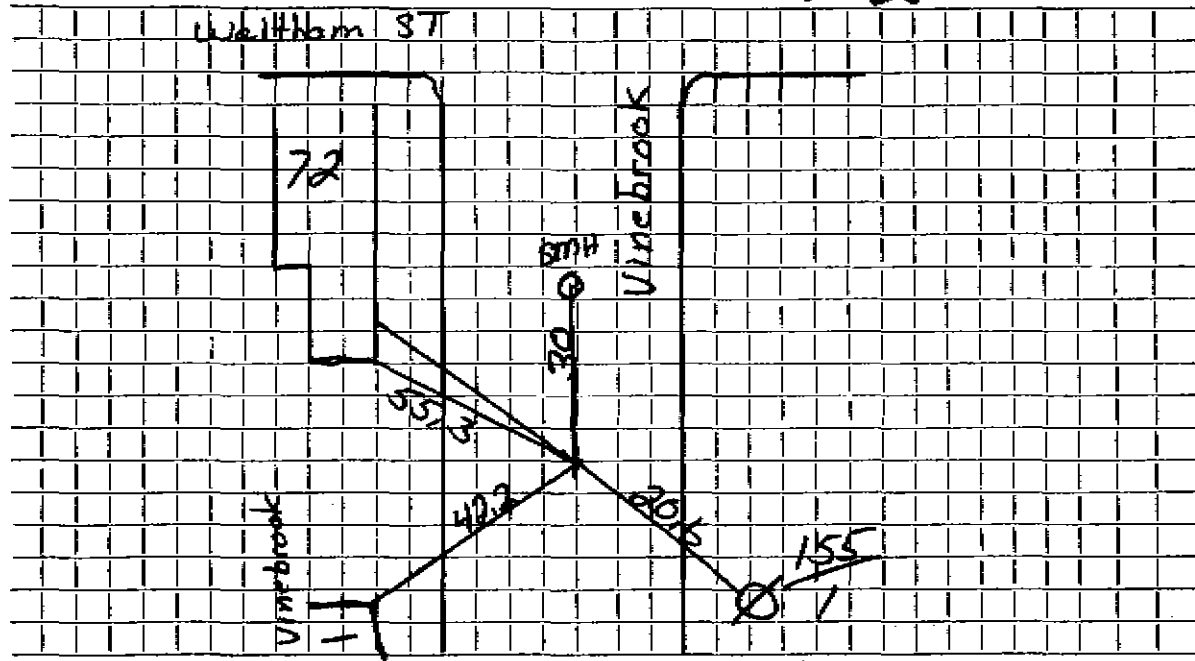

Connection made in ... Vinebrook Rd ... Street. Work completed ... 12-11-90 .....

Remarks: Wye 6'10" deep ... Original Service 1927 .....