


TOWN OF LEXINGTON — BOARD OF PUBLIC WORKS
 DATE _____

SEWER DIVISION

Sketch of Service Here
741

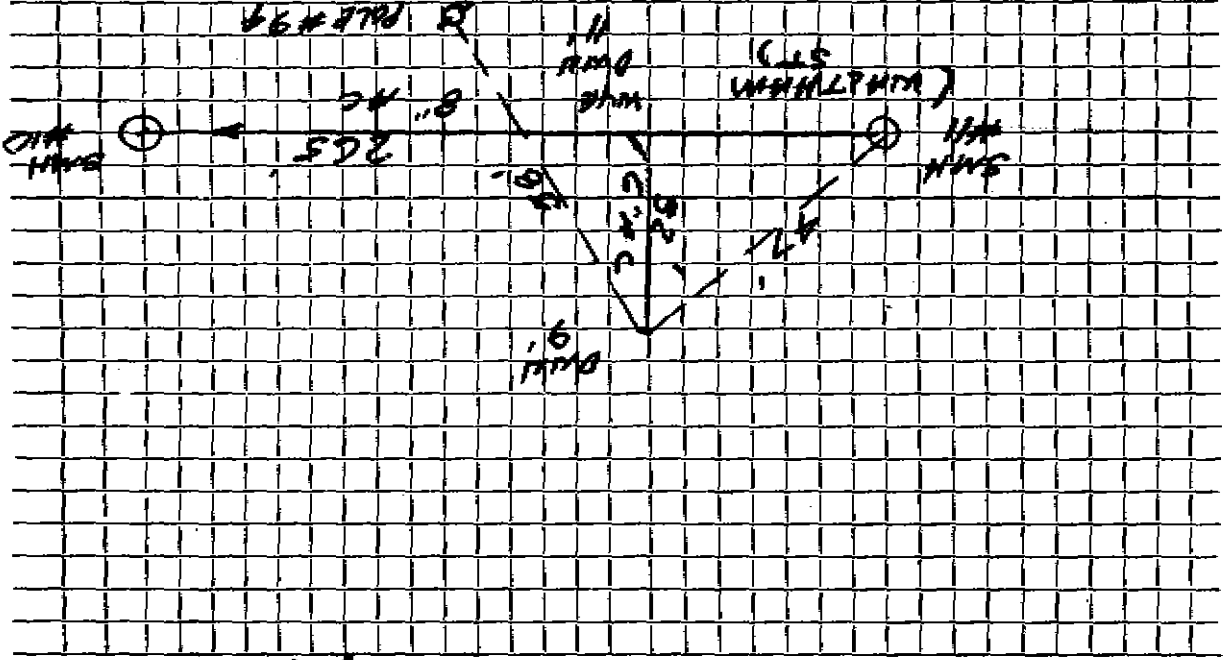

Work completed

Street

Connection made in

Remarks: