

Service No.

Address # 253 Waltham St.
753 Washington Street

Location

Size of Main 8"

Location

Size 6"

Date

Kind of Pipe A-C

Repair—Reopen—New Service


Date	Material	Amount	Total	Date	Amount
6-13 77	5.3' - 6" AC @ \$10.00	\$530.00			

DATE _____

TOWN OF LEXINGTON — BOARD OF PUBLIC WORKS
SEWER DIVISION

Sketch of Service Here

753

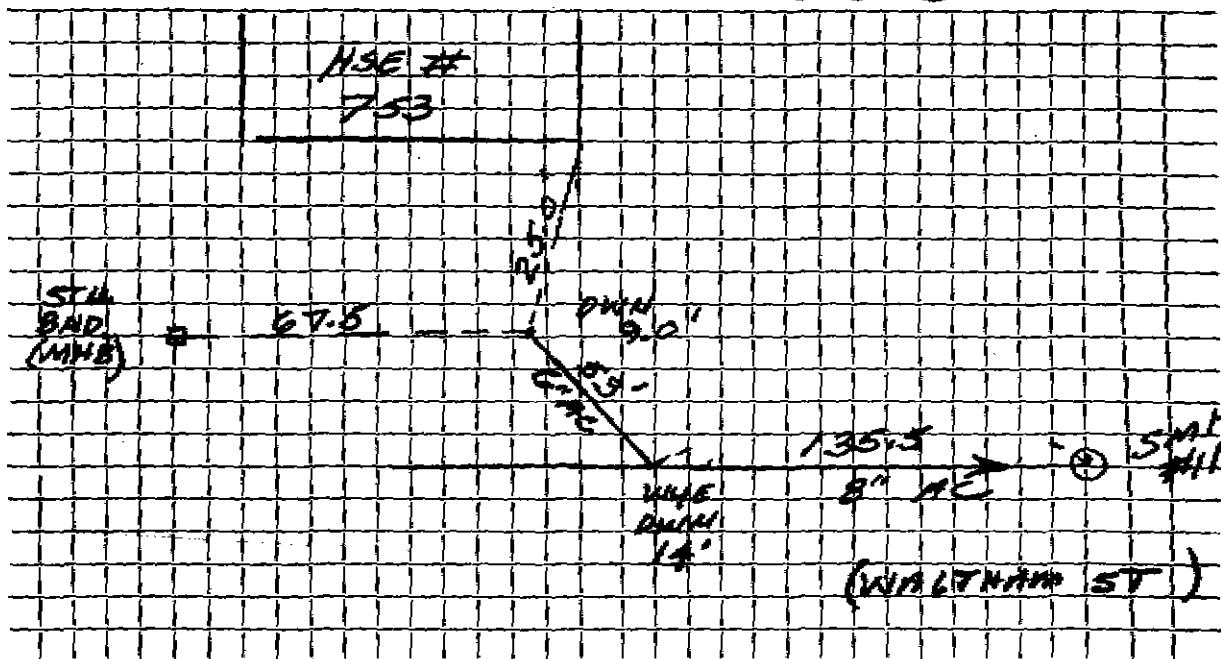

Connection made in Street. Work completed

Remarks: