

Name **Geno Tomao**

Service No. **58**

Address # **758 WALTHAM ST.**

758 Waltham Street

Location

AUG 29 1977

Kind of Pipe **A.C.**

Size **6"**

Size of Main **8"**

Repair—Renewal—New Service

Kirkland & Shaw #3017

Location


Date		Material	Amount	Total	Date	Amount
6-20	77	21'-6" AC P	#10.00	#210 00	7/29/77	Deposit
8/16/77	23'	6" tranche pipe				
					3-16-94	
					Respond @ measure C.T.	
					Possible @ 32'	

DATE _____

TOWN OF LEXINGTON — BOARD OF PUBLIC WORKS

SEWER DIVISION

Sketch of Service Here **758**

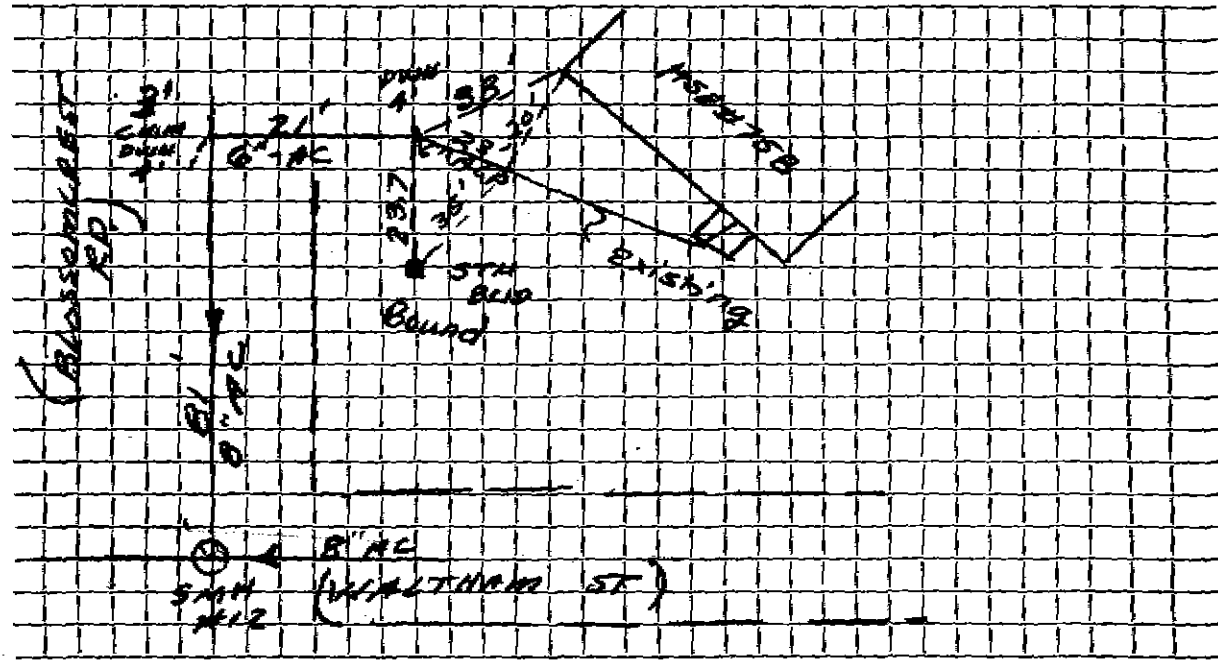

Connection made in Street. Work completed

Remarks:
.....
.....