

Name

Service No.

Address **HSE # 252 WALTHAM ST.**

**759 Waltham Street**

Location

Kind of Pipe **AC.**

Size **6"**

Size of Main **8"**

Repair—Renewal—New Service

Location


Date	Material	Amount	Total	Date	Amount
6-12	77 47' 6" AC	<del>8.12.00</del>	4.92 00		

DATE \_\_\_\_\_

TOWN OF LEXINGTON — BOARD OF PUBLIC WORKS

SEWER DIVISION

Sketch of Service Here **759**

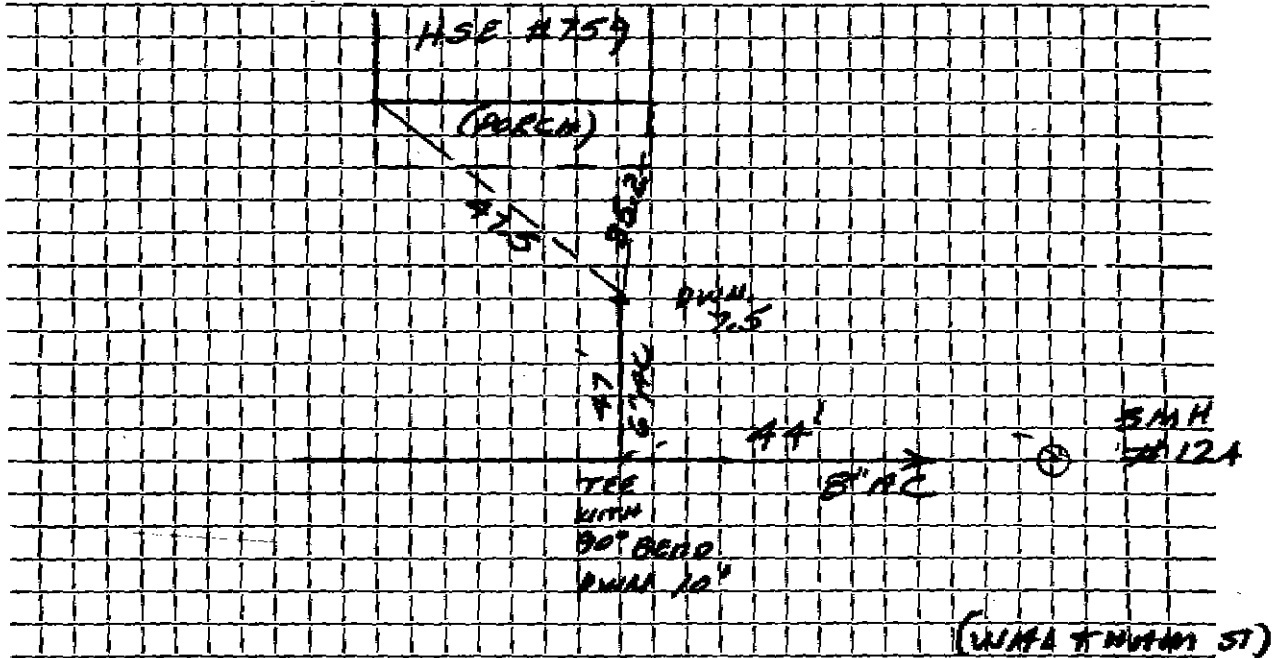

Connection made in ..... Street. Work completed .....

Remarks: .....  
.....  
.....