


DATE 6/14/2019

TOWN OF LEXINGTON — BOARD OF PUBLIC WORKS
SEWER DIVISION

Sketch of Service Here

770

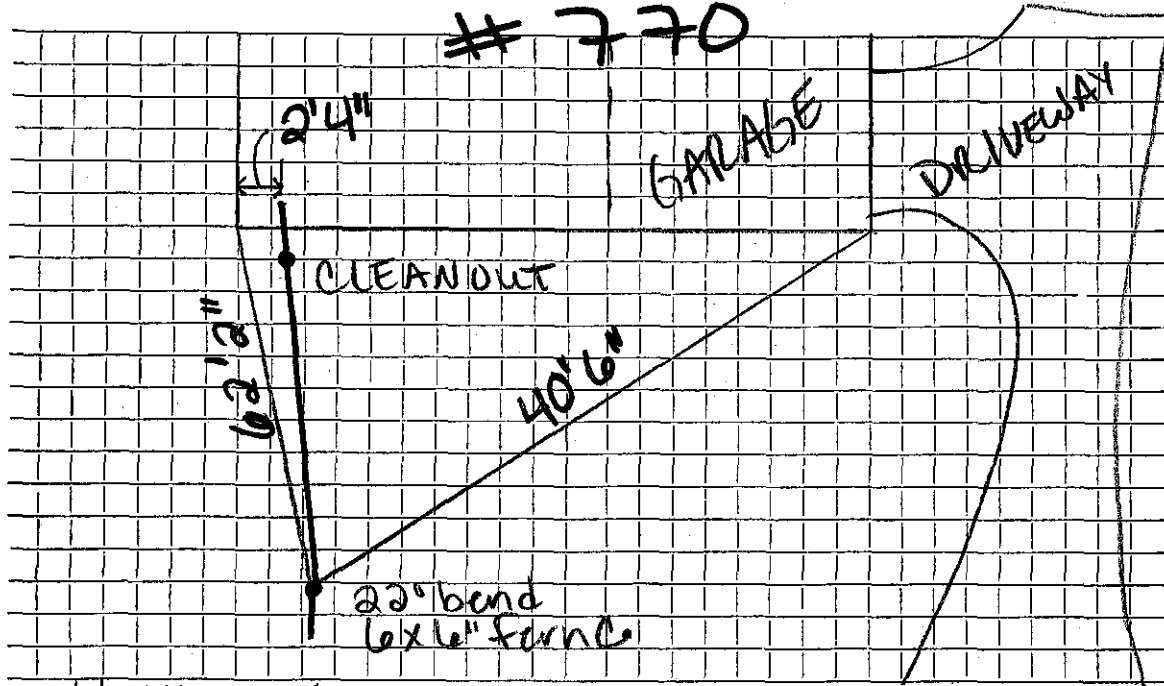

Connection made in Waltham St Street. Work completed

Remarks: