

Name Roy Talanian

Service No. 51

Address #780 WALTHAM ST.

780 Waltham Street

Location

Kind of Pipe A.C.

Size 6"

Size of Main 8"

Repair—Renewal—New Service

Kirkland & Shaw #3013

Location AUG 29 1977


Date		Material	Amount	Total	Date		Amount
6-22	77	22'-6" AC @	\$10.00	\$220 00	7/25/77	Deposit	220.00
8/8/77	45'	6" transite pipe					
	10'	4" cast iron					

DATE \_\_\_\_\_

TOWN OF LEXINGTON — BOARD OF PUBLIC WORKS

SEWER DIVISION

Sketch of Service Here **780**

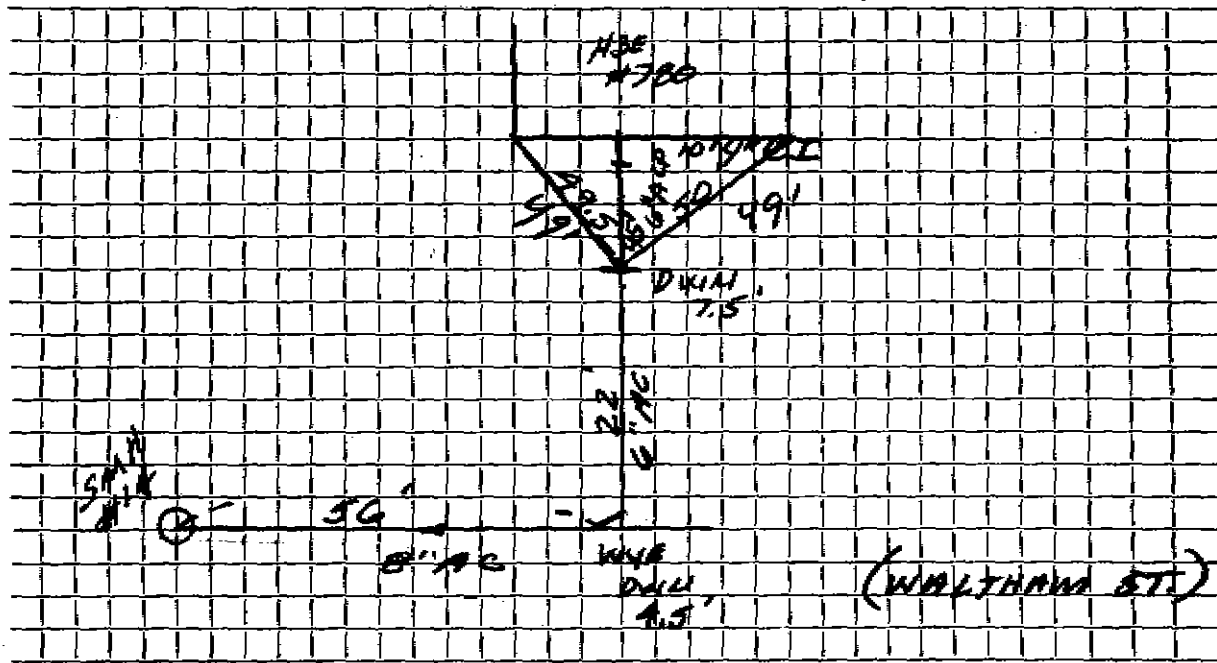

Connection made in ..... Street. Work completed .....

Remarks: .....  
.....  
.....