


DATE 08/31/23

TOWN OF LEXINGTON — BOARD OF PUBLIC WORKS

SEWER DIVISION

Sketch of Service Here
790 Waltham St.

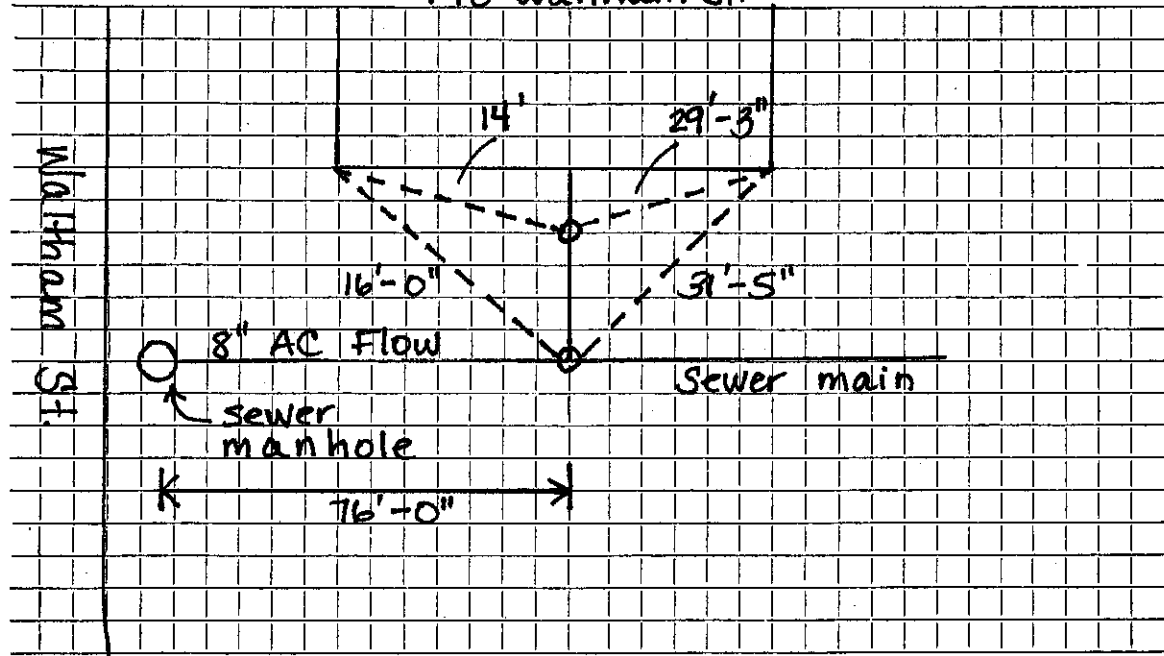

Connection made in Street. Work completed

Remarks: *Installed by J.M. McLaughlin Inc.*