

Name Fred Connor

Service No.

Address #82 WALTHAM ST

82 Waltham Street

Location

Kind of Pipe PVC & VCP

Size 6"

Size of Main 8" VCP

Repair—Renewal—New Service Innitou Const. #3925

Location


Date	Material	Amount	Total	Date	Amount
1929	6" CLAY PIPE				
11/27/84	48' x 6" PVC Pipe				
	1 6" x 45° Elbow				
	1 6" x 4" Fernco Coupling				
					OUTSIDE
				11/27/84	17' 6" PVC Pipe
					1 6" x 6" Fernco Coupling
					1 6" PVC to 6" Clay
					1 Ton Cold Patch
					10 Tons Gravel
					Patch - 13 X 9
				11-26-84	Roots

DATE \_\_\_\_\_

TOWN OF LEXINGTON — BOARD OF PUBLIC WORKS

SEWER DIVISION

Sketch of Service Here **82**

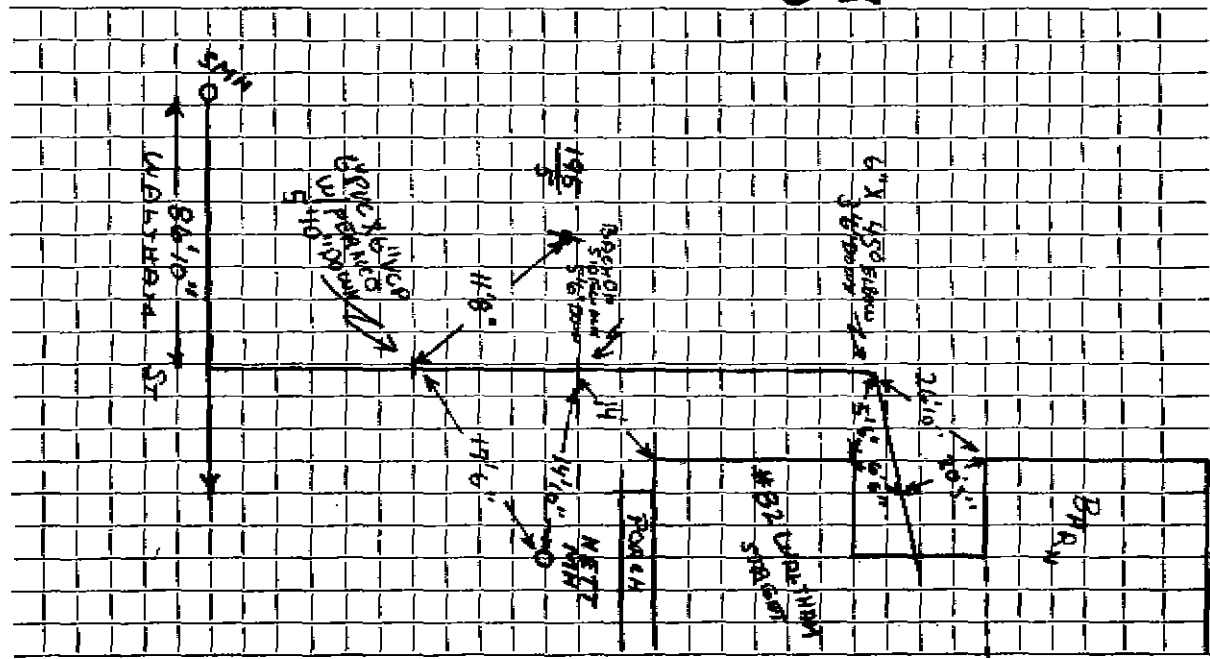

Connection made in W. BATHAM ST ..... Street. Work completed Nov 27, 1984 .....

Remarks: ORIGINAL SERVICE INSTALLED 1929 .....

.....  
.....