

Service No. 1344

Address 87 + 89 Waltham

87 + 89 Waltham Street Location 87 + 89 Waltham Street

Kind of Pipe

Size 6"

Size of Main 8"

Repair—Renewal—New Service

Location

Date	Material	Amount	Total	Date	Amount
1927					
11-15	Repair				
	12' 6" Transit				
	1 6" Adapter				
	Labor				

TOWN OF LEXINGTON - BOARD OF PUBLIC WORKS
SEWER DIVISION

DATE _____

NO. _____


The undersigned applies for the construction of a particular sewer connecting No. 87 & 89 Waltham St. Street and hereby agrees to comply with the Rules and Regulations governing the construction and use of Particular Sewers, as now or at any future time established by the Board of Selectmen.

Am't. of Estimate \$ _____

Am't. Paid \$ _____

Owner _____

Sketch of Service Here

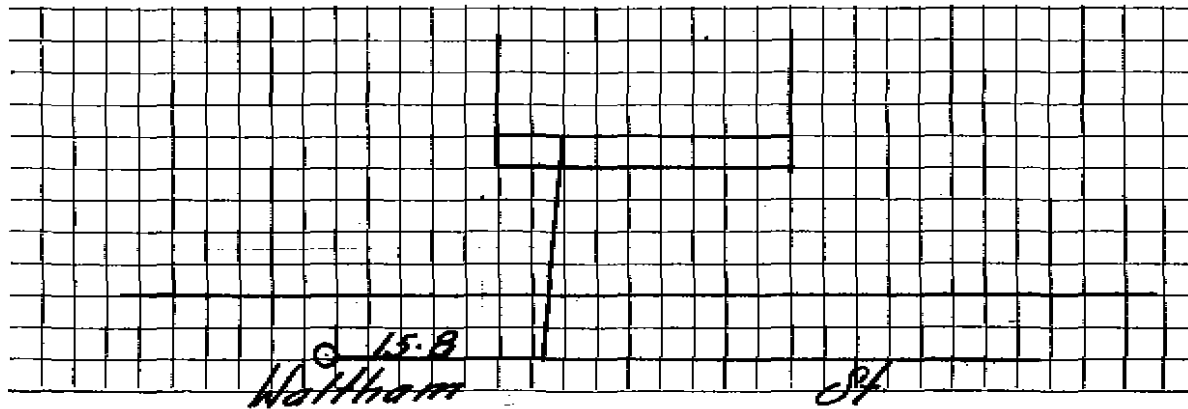

Connection made in _____ Street.

Work completed _____ 19

Remarks: