




DATE FEB 10 1978

TOWN OF LEXINGTON — BOARD OF PUBLIC WORKS  
SEWER DIVISION

Sketch of Service Here

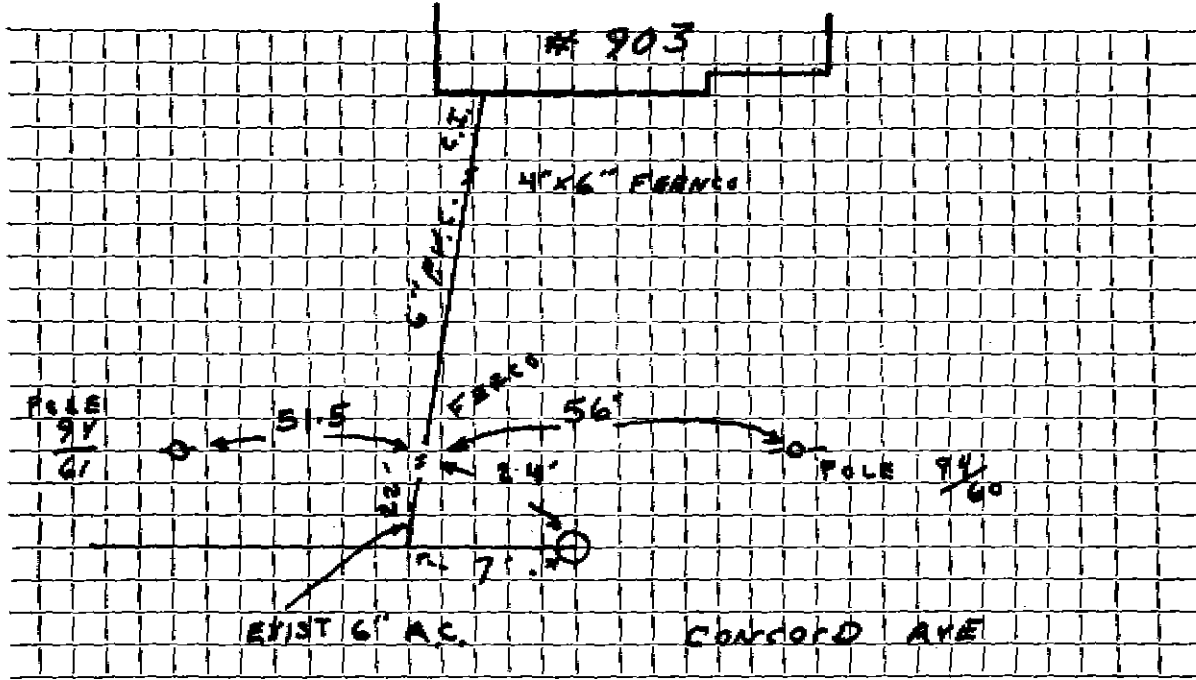

Connection made in CONCORD AVE Street. Work completed EVERNIZZI CORP.

Remarks: .....


FIELD BOOK 28-1 TJM



DATE \_\_\_\_\_

# TOWN OF LEXINGTON — BOARD OF PUBLIC WORKS

## SEWER DIVISION

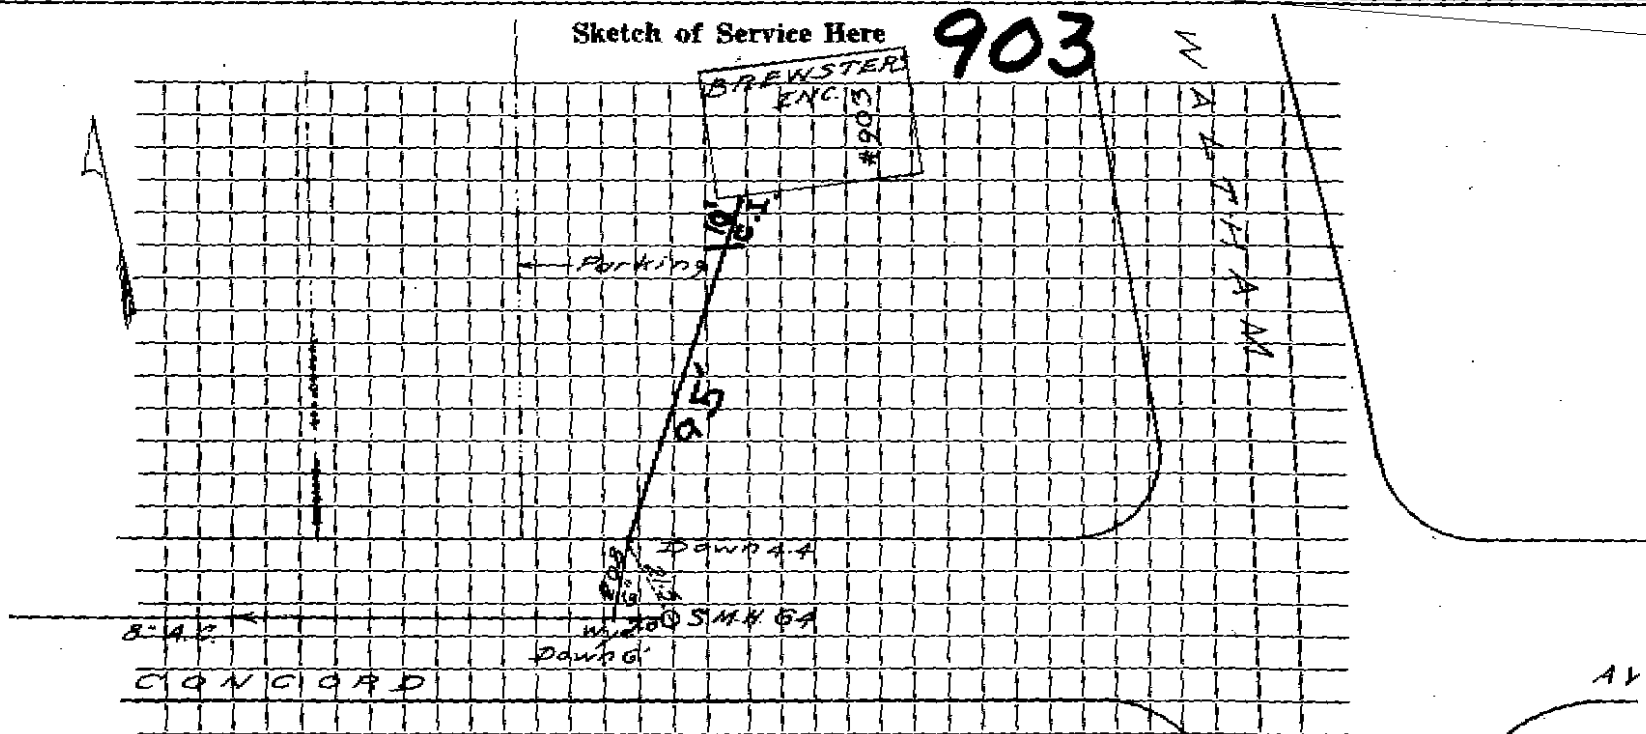

Connection made in **903 WALTHAM ST** Street.

Work completed **5/14/76**

Remarks: .....