


TOWN OF LEXINGTON — BOARD OF PUBLIC WORKS
SEWER DIVISION

DATE

915 Sketch of Service Here

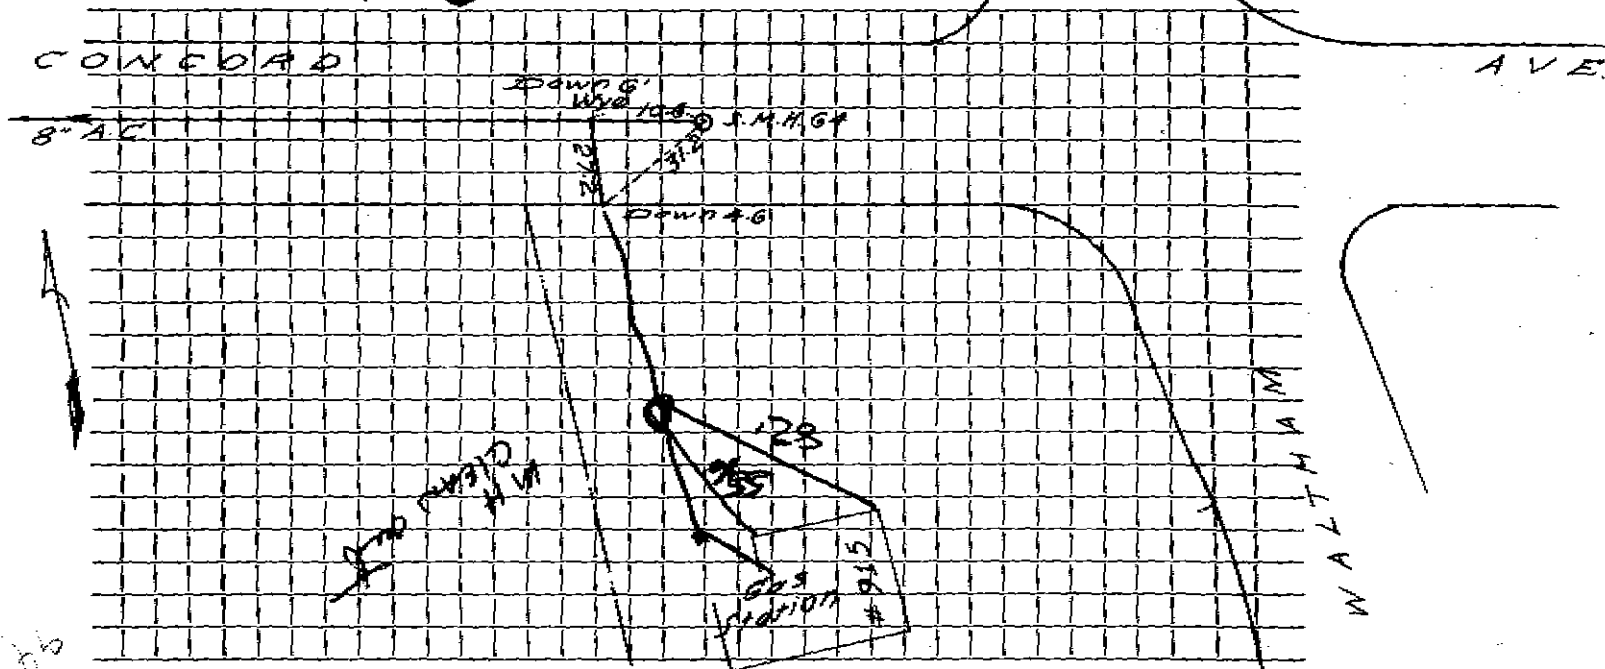

Connection made in Street. Work completed

Remarks: SERVICE installed 1-22-07 small mlt cover over

Plastic clean out