




DATE \_\_\_\_\_

TOWN OF LEXINGTON — BOARD OF PUBLIC WORKS  
SEWER DIVISION

Sketch of Service Here **922**

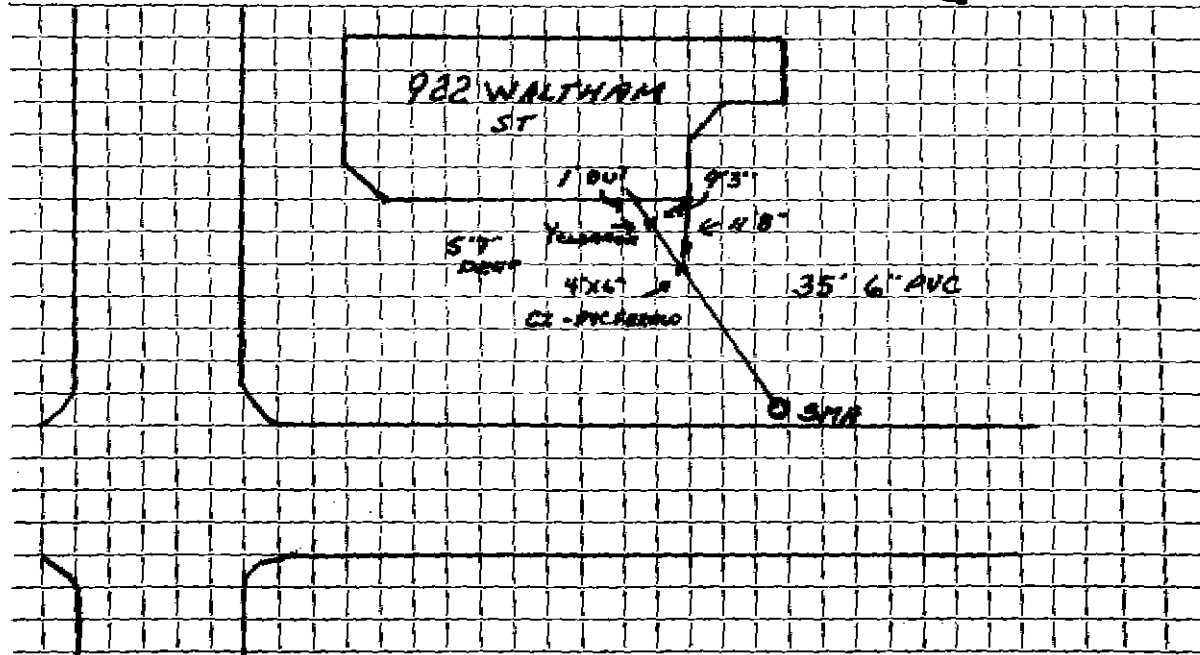

Connection made in ..... Street. Work completed .....

Remarks: .....

.....

.....




DATE \_\_\_\_\_

TOWN OF LEXINGTON — BOARD OF PUBLIC WORKS  
SEWER DIVISION

Sketch of Service Here

922

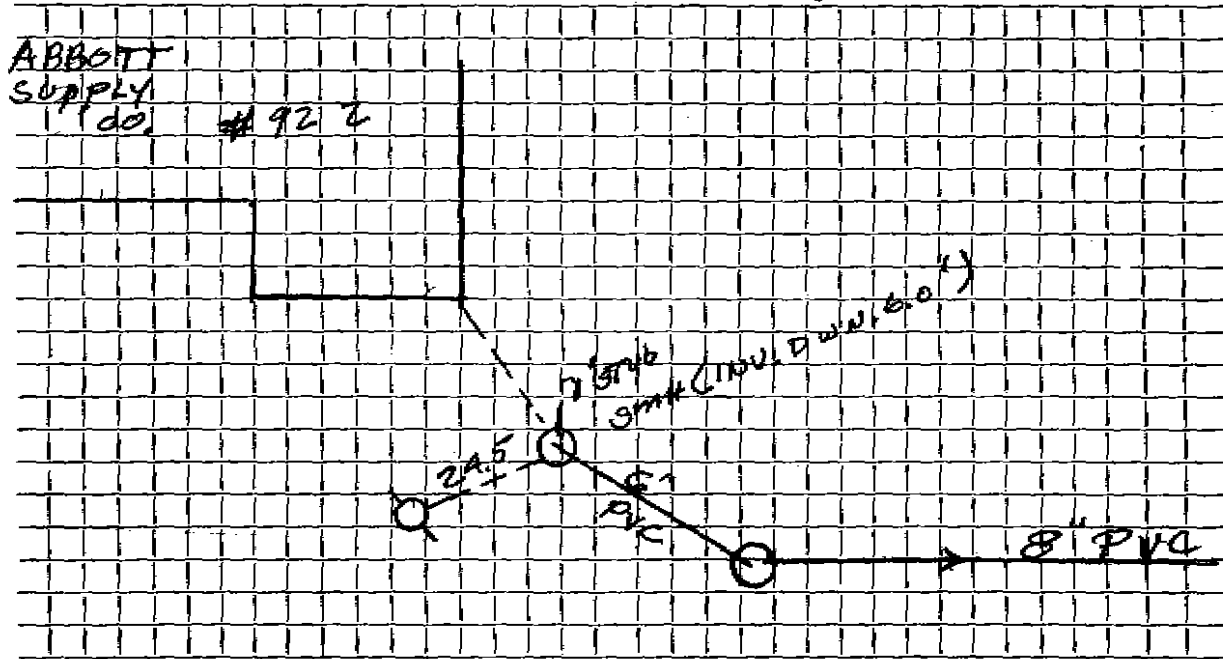

Connection made in ..... Street. Work completed .....

Remarks: .....

.....

.....