




DATE 11-16-82

TOWN OF LEXINGTON — BOARD OF PUBLIC WORKS  
SEWER DIVISION

Sketch of Service Here **952**

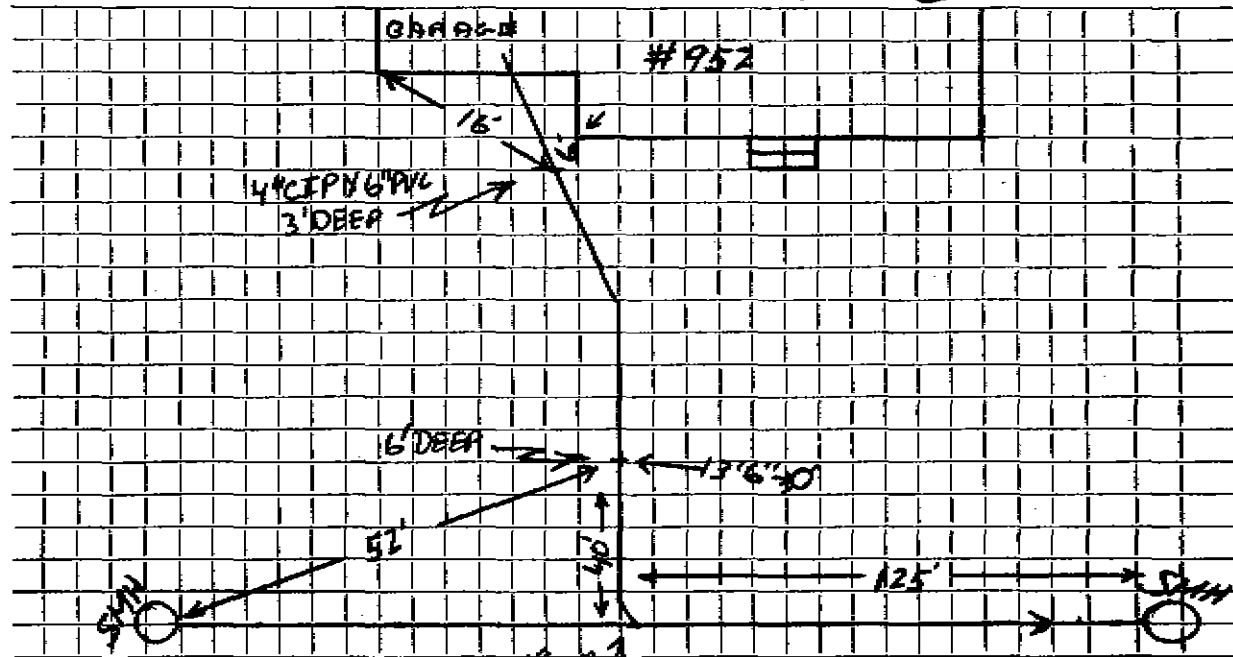

Connection made in W. ANTHONY ST. Street.

Work completed APRIL 26, 1983.

Remarks: .....

.....

.....