


DATE MAY 13, 1983

TOWN OF LEXINGTON — BOARD OF PUBLIC WORKS

SEWER DIVISION

Sketch of Service Here **979**

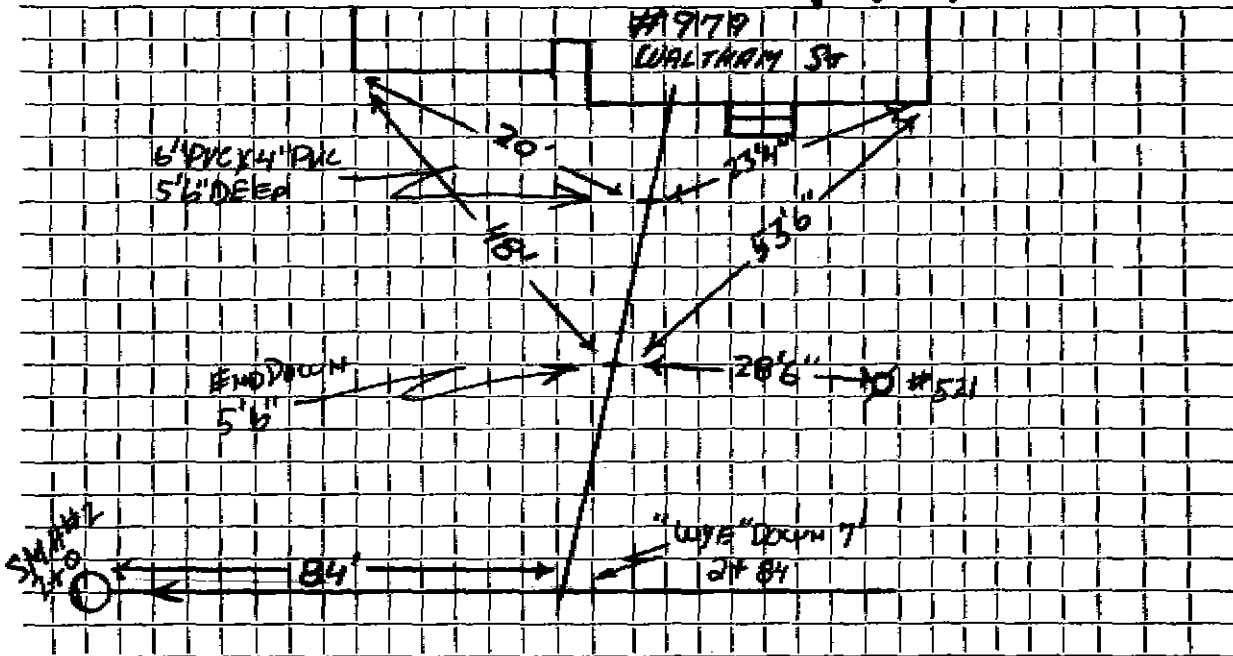

Connection made in WALTHAM ST Street.

Work completed MAY 13, 1983

Remarks: