

Service No.

Address 990 Waltham Street
990 Waltham Street

Location

Kind of Pipe

Size 6"

Size of Main 8"

Repair—Renewal—New Service


Location

Date	Material	Amount	Total	Date	Amount
8-23-79	106' 6" TRANSITE			7-3-76	
	10' 6" TRANSITE				

DATE _____

TOWN OF LEXINGTON — BOARD OF PUBLIC WORKS
SEWER DIVISION

Sketch of Service Here **990**

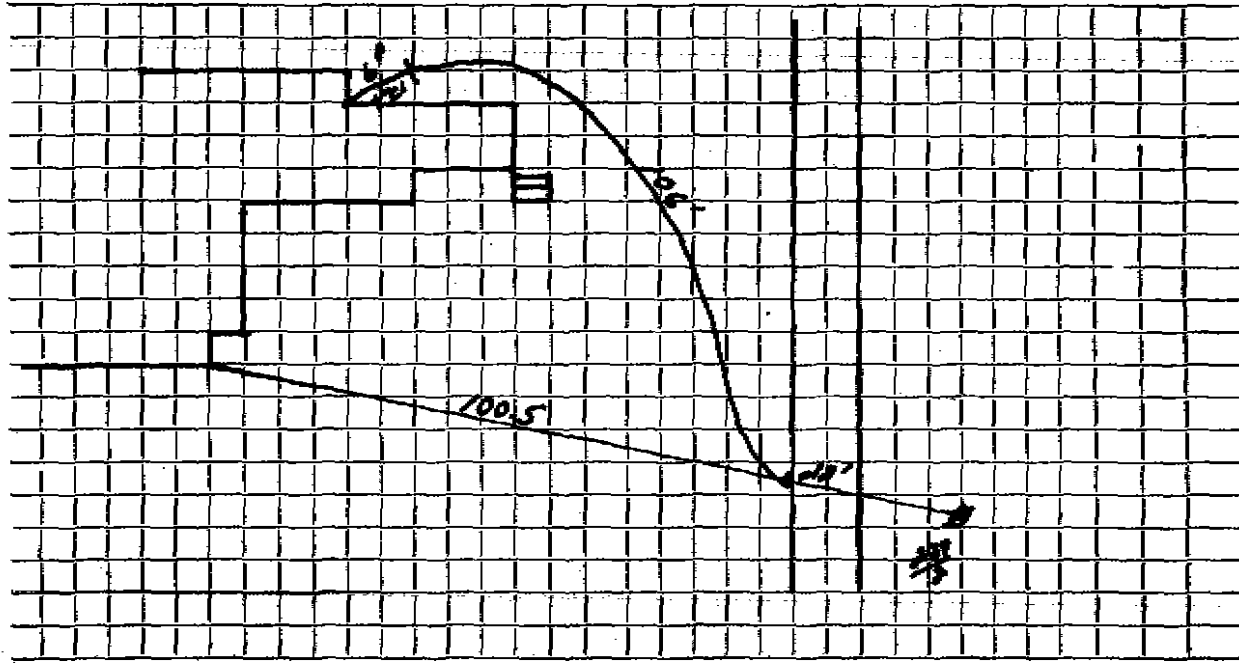

66

Connection made in Street. Work completed

Remarks:

.....

.....