




DATE \_\_\_\_\_

TOWN OF LEXINGTON — BOARD OF PUBLIC WORKS

SEWER DIVISION

Sketch of Service Here

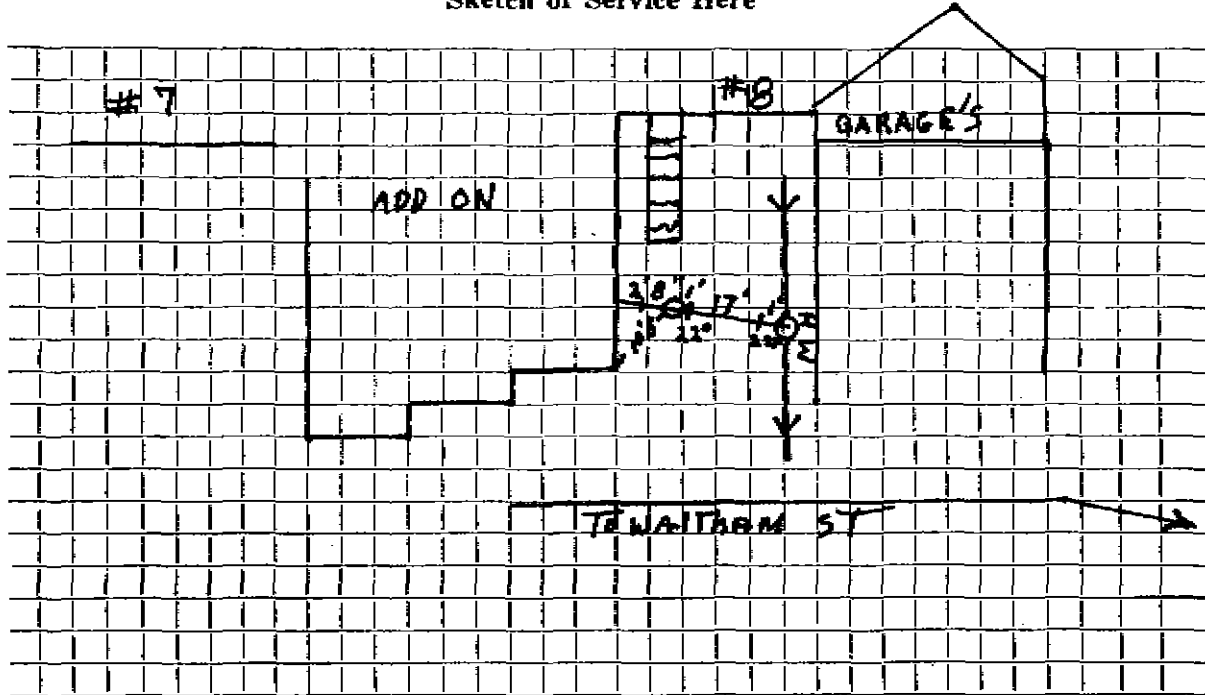

Connection made in TO. EXISTING. MANHOLE Street.

Work completed 9/14/89

Remarks: NO PERMIT