


DATE _____

TOWN OF LEXINGTON — BOARD OF PUBLIC WORKS

SEWER DIVISION

Sketch of Service Here

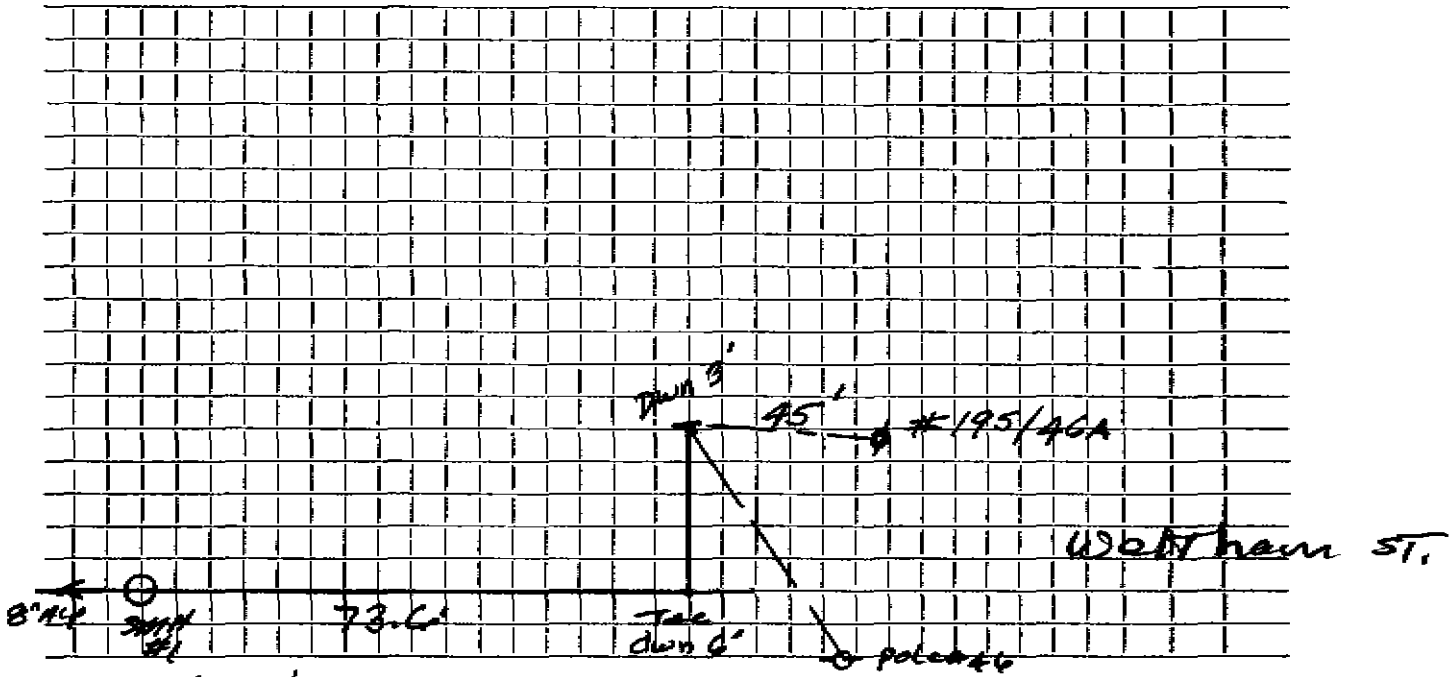

Connection made in Woburn Street. Work completed

Remarks: 18' of 6" DUCT. & 21' of 6" ACP WAS USED (= 39')