

Name Compagnone Corp.

Service No.

Address 15 Ward Street

Lots 1-2-3 15 Ward Street Location

Kind of Pipe

Size 6"

Size of Main 8"

~~Repair Renewal~~ New Service

Location

Date	Material	Amount	Total	Date	Amount
10/87	46' 6" PVC				
	5'5" 4" PVC				
	4" x 6" Fernco				
	6" x 6" Fernco AC to PVC				
1	6" 22° Bend				
				6-15-06	<del>Roots Respond</del> Roots 5' from main - Respond


DATE \_\_\_\_\_

TOWN OF LEXINGTON — BOARD OF PUBLIC WORKS

SEWER DIVISION

Sketch of Service Here

15

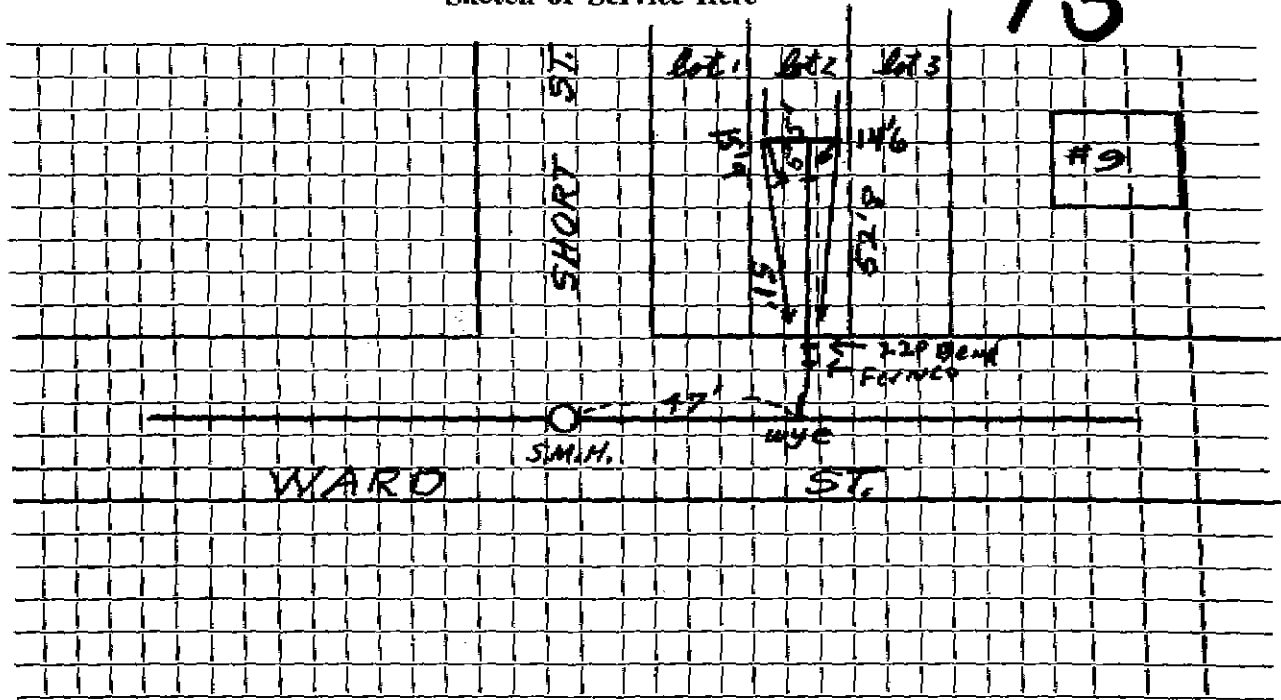

Connection made in ..... Street. Work completed .....

Remarks: .....

.....

.....