

Name

Service No.

Address 25 Ward Street

25 Ward Street

Location

Kind of Pipe

Size 6"

Size of Main 8"

Repair—Renewal—New Service SEWER MAN INC.

Location

Date	Material	Amount	Total	Date	Amount
1967	25' 6" Transite pipe @7.00		175.00		
17/77					
<p>This IS NOW #8 Ash</p> <p>SEE NEW CARD</p>					


DATE \_\_\_\_\_

# TOWN OF LEXINGTON — BOARD OF PUBLIC WORKS

## SEWER DIVISION

Sketch of Service Here

# 25

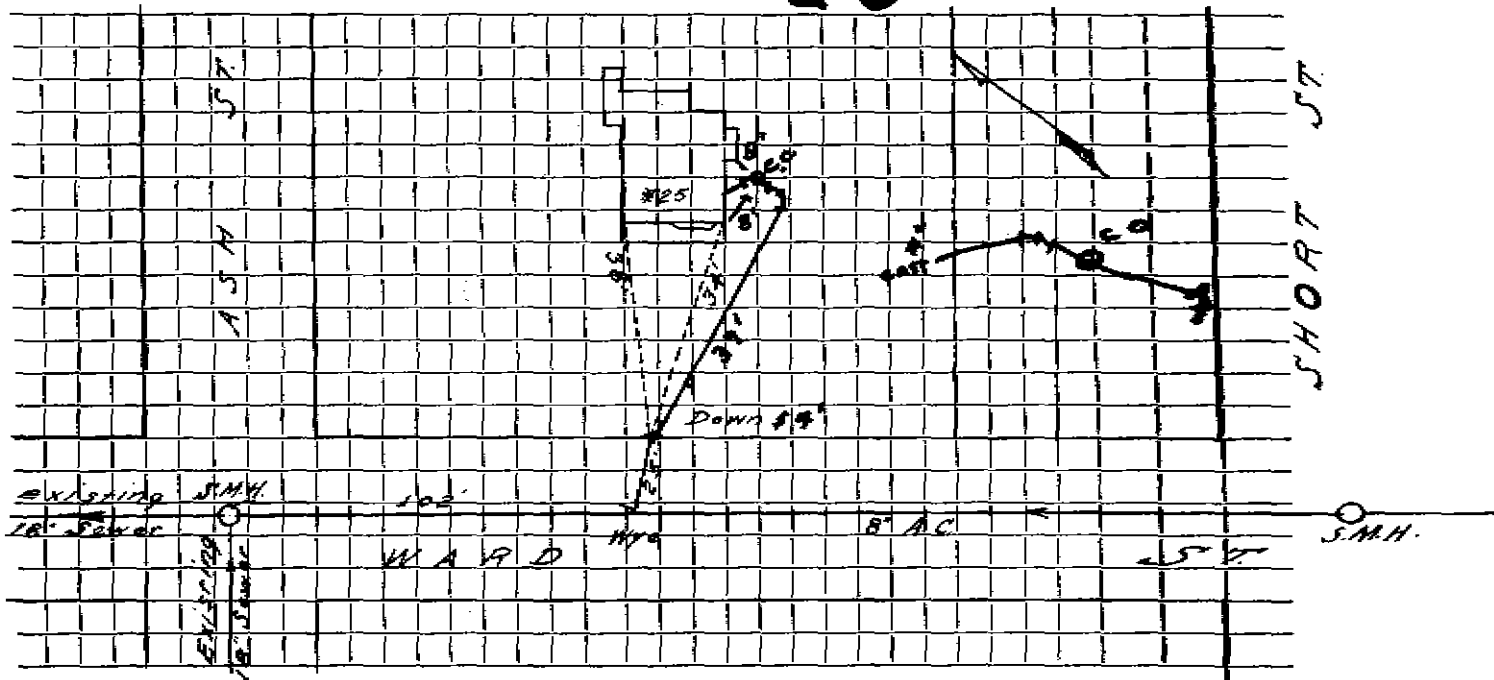

Connection made in ..... Street. Work completed .....

Remarks: SEE FRONT CARD Tie C.O. ....

.....  
.....