

Name

Service No.

Address 36 WARD ST

36 WARD STREET

Location

Kind of Pipe 6" PVC REDMOND

Size 6"

Size of Main 8"

Repair—Renewal—New Service

Location

Date	Material	Amount	Total	Date	Amount
4/10/75	69' 6" PVC				
	3-6" 22° BENDS				
	1- 4X6 FRANCO				


DATE \_\_\_\_\_

TOWN OF LEXINGTON — BOARD OF PUBLIC WORKS

SEWER DIVISION

Sketch of Service Here

36

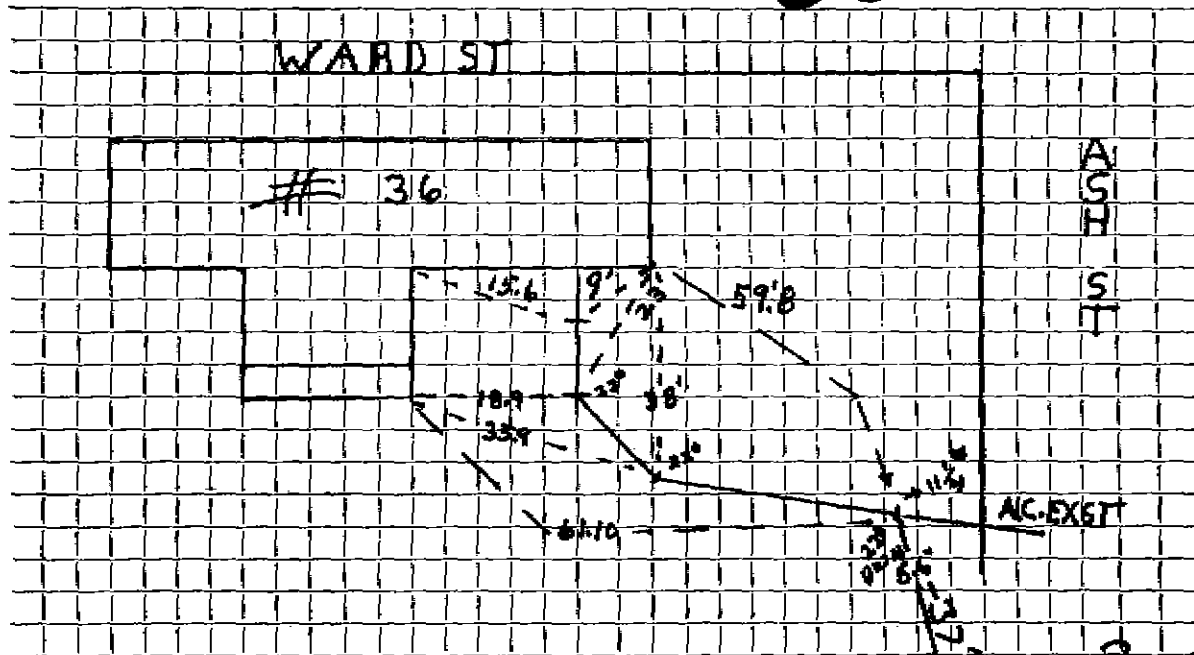

Connection made in ASH ST Street. Work completed \_\_\_\_\_

Remarks: Using same chimney as # 11 Ash. If I.F. you need to cap out chimney, you have to use # 11 Ash to gain access.