

Name Carmine Cuccinello

Service No. 178
(1956)

Address 37 Ward Street

37 Ward Street

Location

Comm. 3/18/57

Kind of Pipe

Size 6"

Size of Main 8"

~~Repair~~ New Service

Location

Date	Material	Amount	Total	Date	Amount
12-4-57	Labor	74.10		11-23-56	Deposit \$ 250.00
	10% O.H.	7.41	81.51	3-18-57	Refund 91.47
	57' 6" Sewer pipe @.435		24.80		\$ 158.53
	Joint Compound		3.48		
	4 hrs. Town Shovel @6.50		26.00		
	2 hrs. Trucking @.75		1.50		
	1 6" Bend		1.24		
	20 x 3 Patch		20.00		
			158.53		
	Labor				

TOWN OF LEXINGTON—DEPT. OF PUBLIC WORKS

SEWER DIVISION

DATE

NO.


The undersigned applies for the construction of a particular sewer connecting No.
Street and hereby agrees to comply with the Rules and Regulations governing the construction and use of Particular
Sewers, as now or at any future time established by the Board of Selectmen.

Am't of estimate \$.....

Am't Paid \$.....

..... Owner

Sketch of Service Here

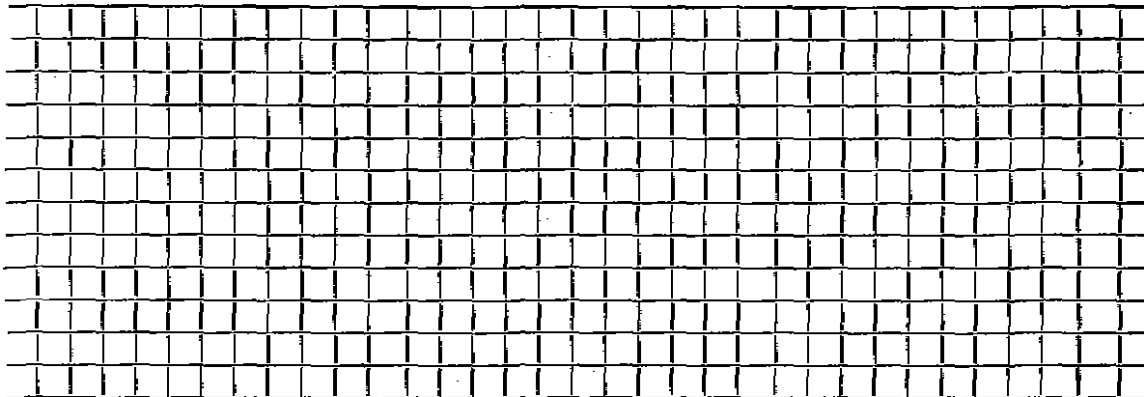

Connection made in Street.

Work completed 19..

Remarks: