

Name Robert P. Franks

8625953 Abated 24.76

Service No. 119

Address 38 Ward Street

8/15/67

38 Ward Street

Location

Kind of Pipe

Size 6"

Size of Main 8"

Repair—Renewal—New Service

Grant #A432 W.O. #3284

Location

JUL 24 1967

Date	Material	Amount	Total	Date	Amount
21/66	Labor	93.72		9-19-66	125.00
	10% O.H.	9.37	103.09	8-15-67	24.76
25'	Transite Pipe @.88		22.00	3-11-68	41.48
1	6x6 Tee		28.85	409	166.68
1	Ton Cold Patch		5.50		
2	hr. Trucking @3.00		6.00		
2	hr. Compressor @5.00		10.00		
1	hr. Roller		3.00		
2	hr. Town Shovel @6.50		13.00		
			191.44		
3/66	35' 6" Transite		166.68		
	10" Cast Iron				


Dis. sent 4/68

DATE _____

TOWN OF LEXINGTON — BOARD OF PUBLIC WORKS

SEWER DIVISION

Sketch of Service Here **38**

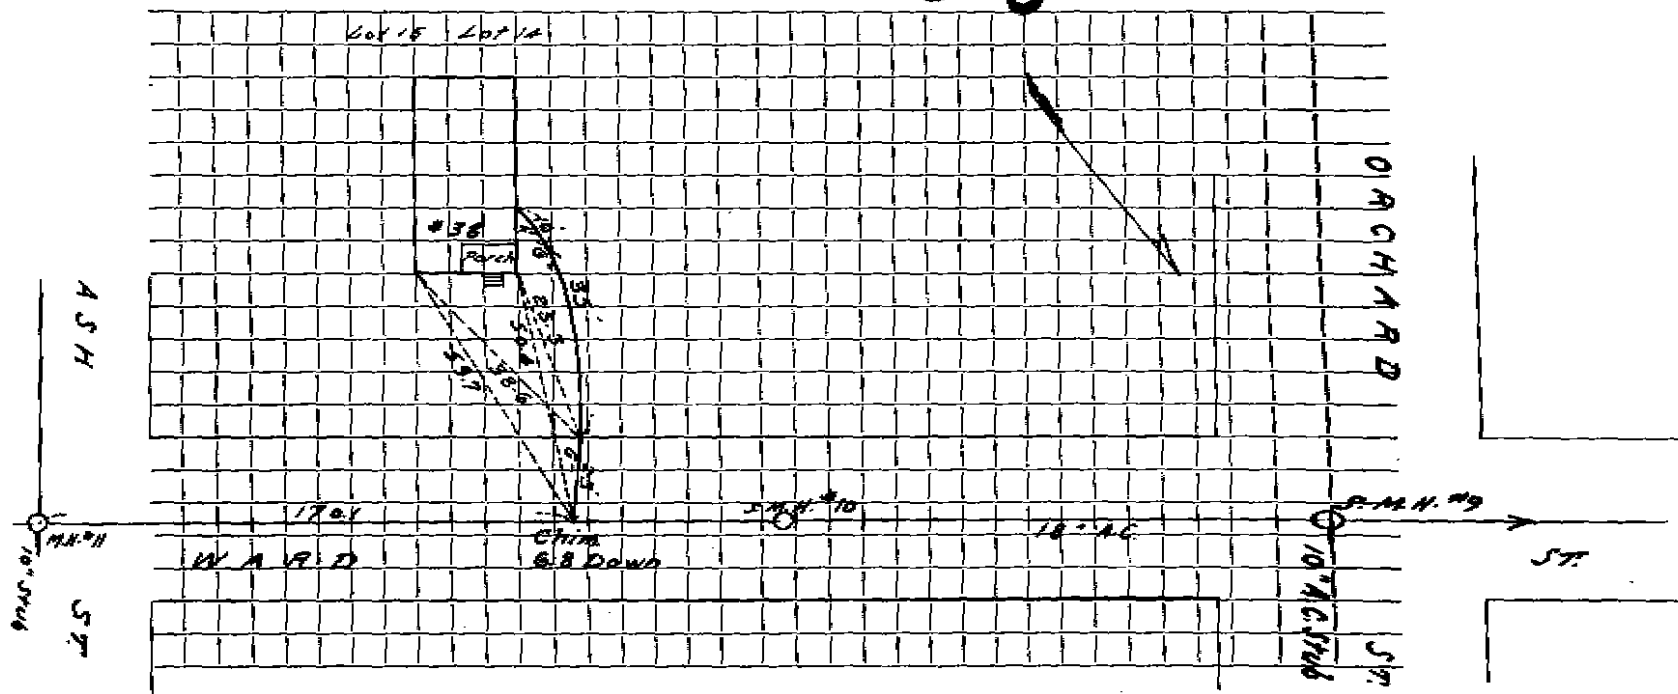

Connection made in Street. Work completed

Remarks:

.....

.....