




DATE 10-19-'90

TOWN OF LEXINGTON — BOARD OF PUBLIC WORKS  
SEWER DIVISION

Sketch of Service Here

4

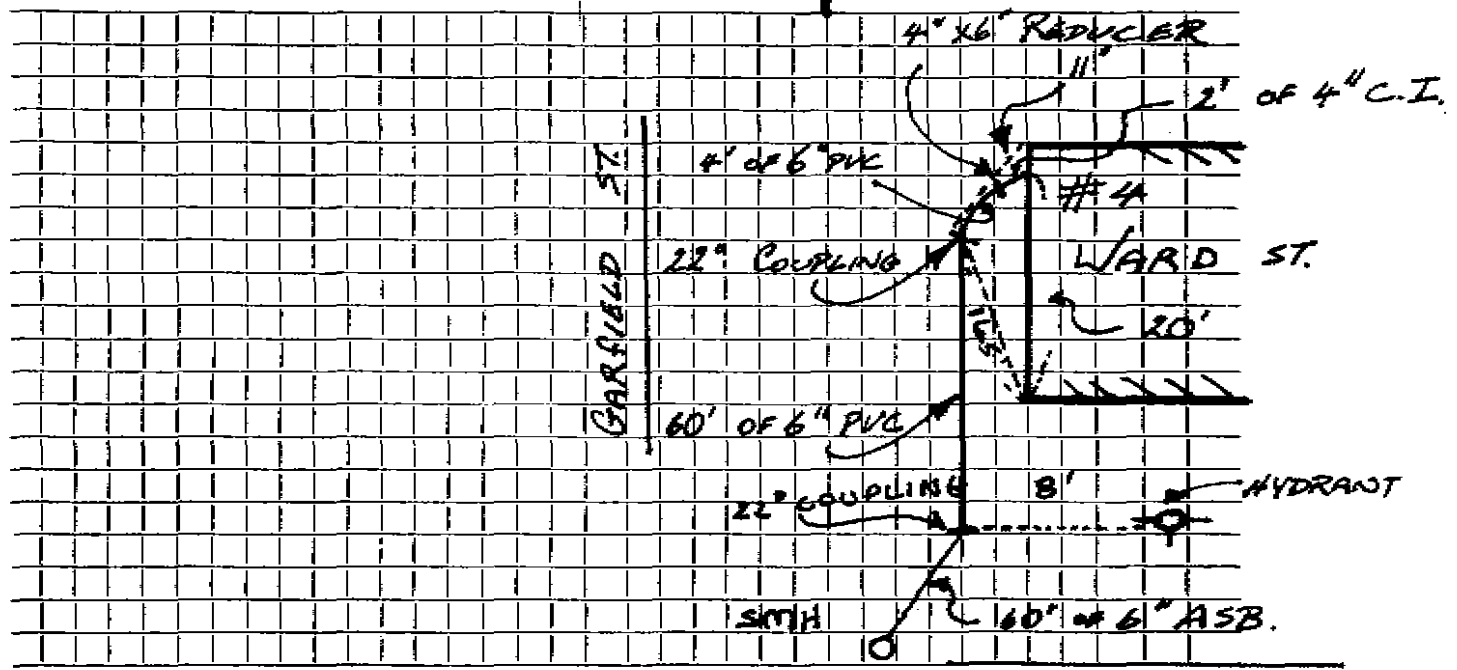

Connection made in GARFIELD Street. Work completed WARD ST.

Remarks: PETER CHALPIN (ASST. TOWN ENG.) RECOMMENDED THAT THE PIPE BE RAISED 15" AT THE HOUSE. THEY (ARLOX) CHOSE NOT TO. ALSO SLOPE COULD NOT MEET 2% MIN.