

Name Harold S. Pierce

Service No. 80

Address # 42 Ward Street

42 Ward Street

Location

Kind of Pipe

Size 6"

Size of Main 8"

~~Residence~~ New Service W. O. # 8903 Valeri #1711

Location NOV 23 1970


Date	Material	Amount	Total	Date	Amount
12/21/70	Labor	113 40		8-19-70	200 00
12/22/70	"	13 66	127 06	12-17-70	34 07
	10% O.H.		12 71		234 07
25'	6" Transite pipe .90		22 50		
1	6" Plug		3 80		
1/2	Ton cold patch 6.00		3 00		
1/2	Yd. loam 3.50		1 75		
1	Crusher run		2 75		
2	Hrs. Trucking 3.00		6 00		
3	" Shovel 6.50		19 50		
1	" Compressor		5 00		
	Patching		30 00		
			234 07		
6/70	48' 6" Transite pipe				
	15' 4" Cast Iron Pipe				
					Bill sent 24-07

DATE _____

TOWN OF LEXINGTON — BOARD OF PUBLIC WORKS

SEWER DIVISION

Sketch of Service Here **42**

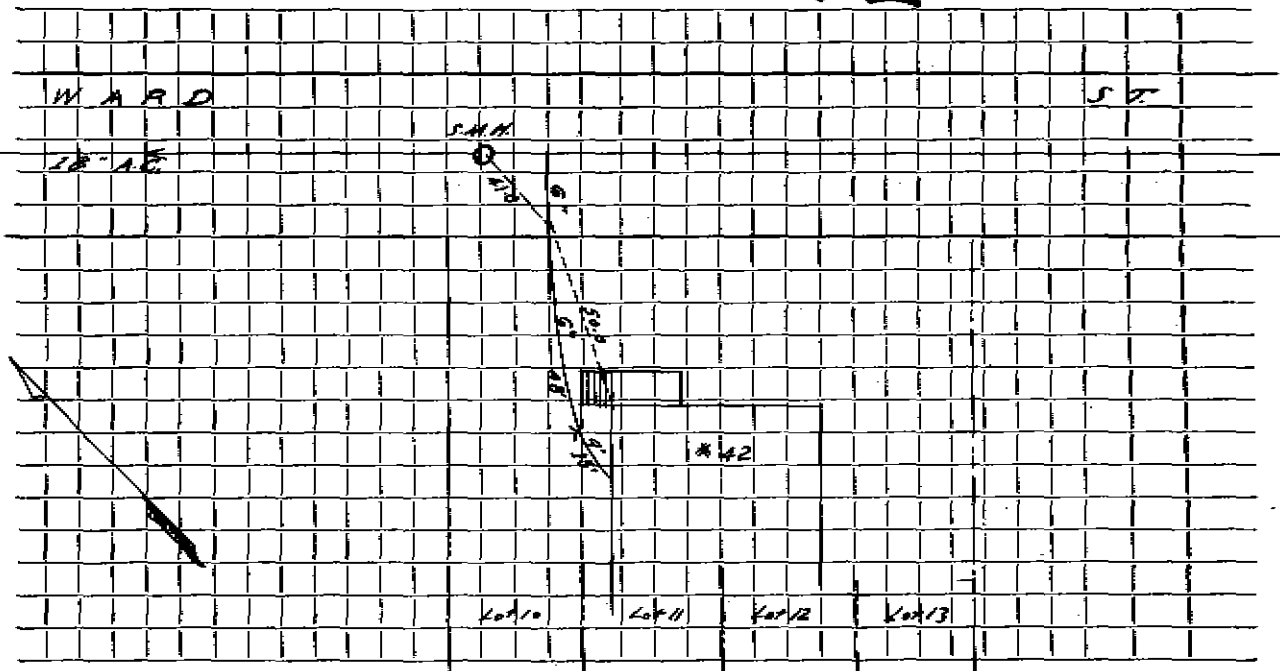

Connection made in Street. Work completed

Remarks:
.....
.....