

Name **Albert C. Gaccinello**

Service No. **151**

Address **45 Ward Street**

45 Ward Street

Location

Comm. 11-18-57

Kind of Pipe

Size **6"**

Size of Main **8"**

~~Repair—Renewal—New Service~~

Installed by contractor

Location

Date	Material	Amount	Total	Date	Amount
9/12/57	Labor	99 23		9-12-57	\$ 200 00
	10% overhead	9 92	109.15	11-18-57	<i>Deposit Paid by refund on W.N.C. # 199</i> 2 55
	70' - 6" Transite Pipe @ .70		49 00	12-3-57	<i>Paid</i> 12 44
	1 - 6" Clay Tee		1 88		\$ 214 99
	6' - 8" Sewer Pipe @ .868		5 21		
	3 hrs. Trucking @ .75		2 25		
	5 hrs. Shovel @ 6.50		32 50		
	5 hrs. Hough Loader @ 3.00		15 00		
			214 99		
	Labor				<i>Bill sent 11-21-57 \$ 12.44</i>

TOWN OF LEXINGTON—DEPT. OF PUBLIC WORKS
SEWER DIVISION

DATE.....

NO.


The undersigned applies for the construction of a particular sewer connecting No.....
Street and hereby agrees to comply with the Rules and Regulations governing the construction and use of Particular
Sewers, as now or at any future time established by the Board of Selectmen.

Am't of estimate \$.....

Am't Paid \$.....

..... Owner

Sketch of Service Here

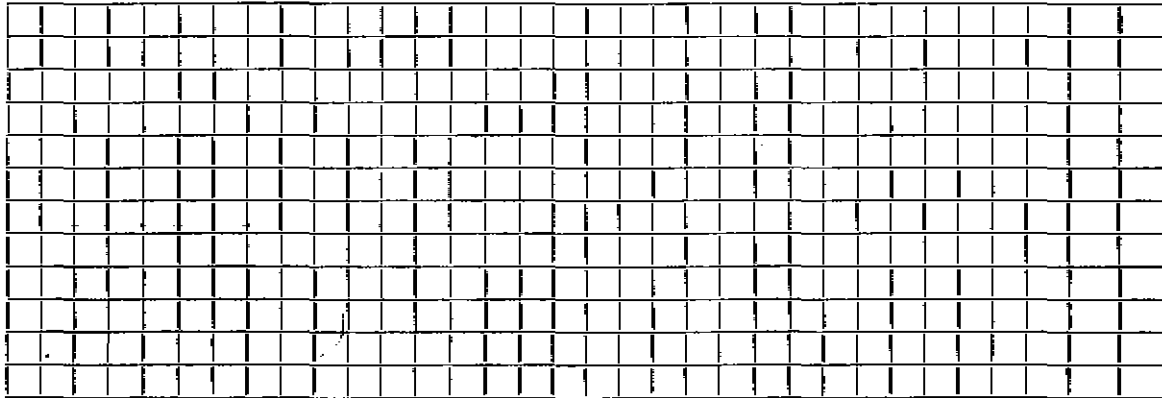

Connection made in..... Street. Work completed.....19..

Remarks: