


DATE 7/31/19

TOWN OF LEXINGTON — BOARD OF PUBLIC WORKS
SEWER DIVISION

Sketch of Service Here

49

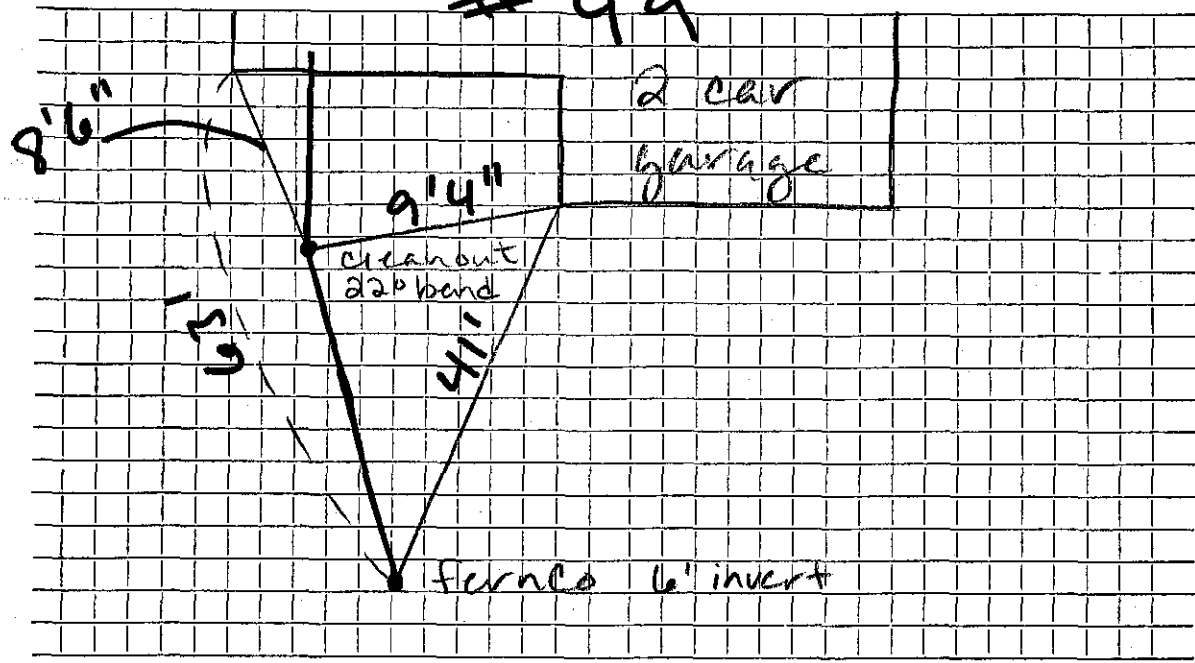

Connection made in Ward Street. Work completed

Remarks:

.....

.....