

Name Weymouth Whitney

Service No. 87

Address 51 Ward Street

51 Ward Street

Location

Kind of Pipe

Size 6"

Size of Main 8"

~~XXXXXXXXXXXX~~ New Service David Eagle Cont. W.O. # 8947

Location NOV 23 1970

Date	Material	Amount	Total	Date	Amount
9/16/70	Labor	89 00		9-7-70	Deposit 160 00
9/22/70	"	13 66	102 66	9-13-72	Balance Paid 11 59
	10% O.H.		10 27		171 59
	20' 6" Transite pipe	90	18 00		
	1 Coupling		1 66		
	2 Hrs. Trucking	3.00	6 00		
	2 Hrs. Shovel	6.50	13 00		
	1 Hr. Compressor		5 00		
	Patching		15 00		
			171 59		
1/8/70	31' 6" Transite pipe				
	10' 4" Cast Iron pipe				


DATE \_\_\_\_\_

TOWN OF LEXINGTON — BOARD OF PUBLIC WORKS

SEWER DIVISION

Sketch of Service Here

51

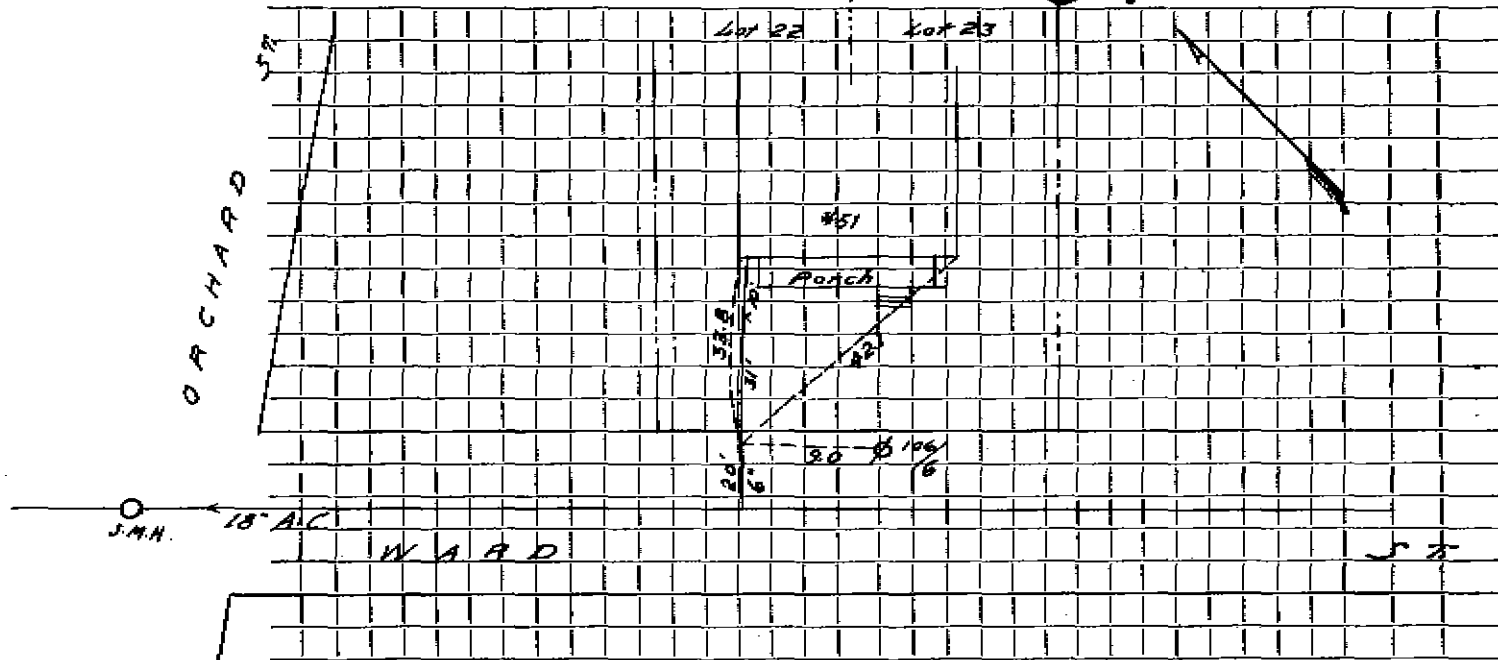

Connection made in ..... Street. Work completed .....

Remarks: .....  
.....  
.....