

Name Donna Realty Trust

Service No. 101

Address 53 Ward Street

53 Ward Street

Location

Kind of Pipe

Size 6"

Size of Main 8"

~~Revised Estimate~~ - New Service Grant #A372 W.O. #3115

Location JUL 24 1967

Date	Material	Amount	Total	Date	Amount
2-29-66	Labor	19.20		8-3-66	125 00
6-66	"	26.37			
4-66	Patching	17.31	62.88		
	10 % O.H.	6.29	69.17		
	20' 6" Transite pipe @.88		17.60		
	1 18 x 6 Transite saddle		7.50		
	2 ton Hot Top @5.50		11.00		
	500 lbs Cold Patch @5.00		1.25		
	3 hrs. Trucking @3.00		9.00		
	2 hrs. Tractor @6.50		13.00		
	1/2 hr. Roller @3.00		1.50		
	1/2 hr. Compressor @5.00		2.50		
			132.52		
7-66	24' 6" Transite pipe				

Bill sent 7-28-67


DATE _____

TOWN OF LEXINGTON — BOARD OF PUBLIC WORKS

SEWER DIVISION

Sketch of Service Here

53

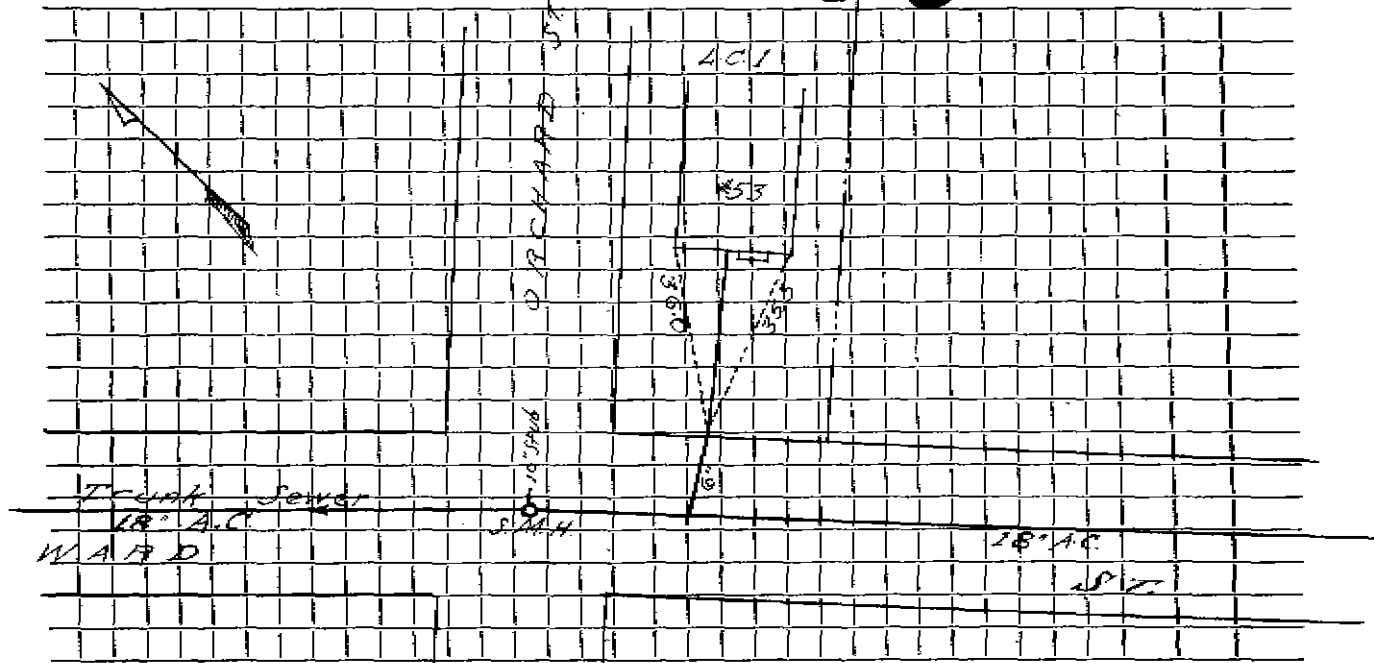

Connection made in Street. Work completed

Remarks:

.....

.....