

Name Kenneth P. Kelley, Jr.Service No. 57Address 54 Ward St. - Lexington54 Ward Street

Location

Kind of Pipe

Size 6"Size of Main 8"~~Repair~~ ~~Work~~ New Service DeFlice #1415  
W.O. # 6529Location SEP 2 1969


Date	Material	Amount	Total	Date	Amount
7/7/69	Labor	43 11		6-19-69	200 00
7/14/69	"	10 94	54 05	9-3-69	95 52
	10% O.H.		5 41		104 48
25'	6" Transite pipe .88		22 00		
1	90o Elbow		4 09		
2	6" Couplings .91		1 82		
1/2	Bag cement 1;55		78		
2	Dozen brick .04 1/2		1 08		
1/2	Ton cold patch 5.50		2 75		
1	Hr. Town shovel		6 50		
1	" Trucking		3 00		
1	" Roller		3 00		
			104 48		
7-18-69	28' 6" Transite pipe				
	10' 4" Cast Iron pipe				

DATE \_\_\_\_\_

TOWN OF LEXINGTON — BOARD OF PUBLIC WORKS  
SEWER DIVISION

Sketch of Service Here

54

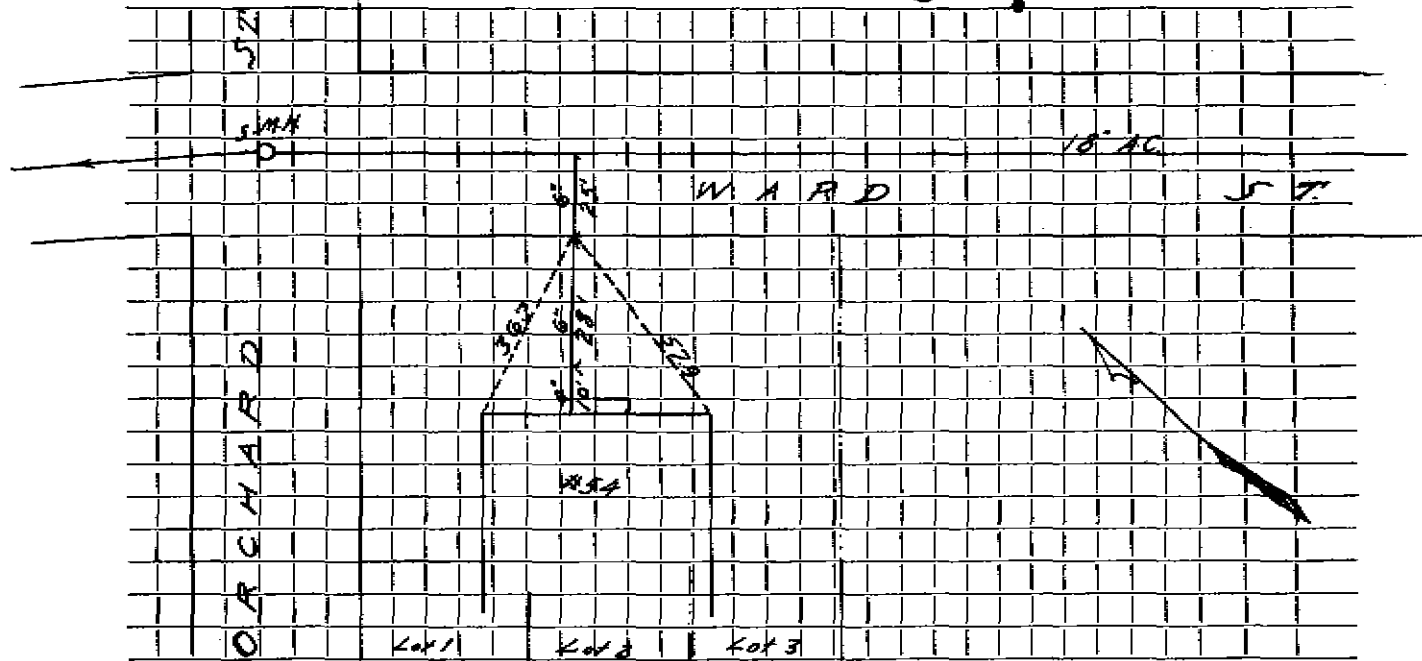

Connection made in ..... Street. Work completed .....

Remarks: .....

.....

.....