


Date: June, 2021

TOWN OF LEXINGTON - BOARD OF PUBLIC WORKS
SEWER DIVISION

SKETCH OF SERVICE HERE
59 Ward St.

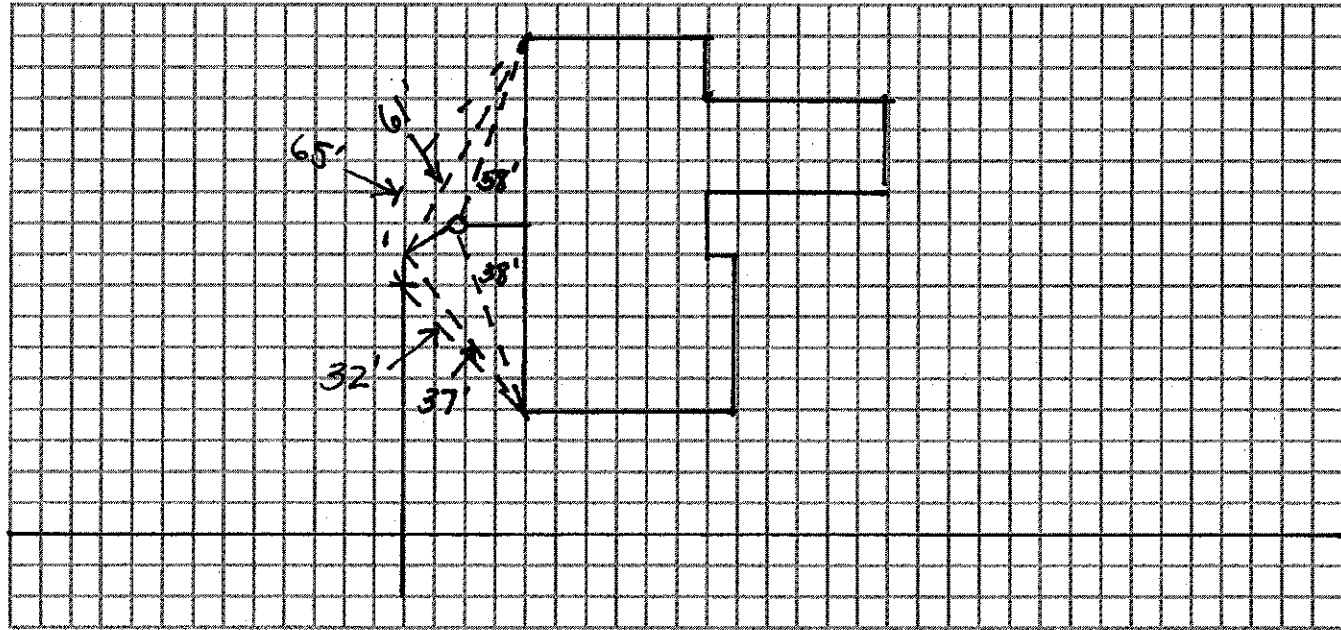

Connection made in:

Street.

Work completed:

Remarks: Installed by Bradley Landscaping