


DATE 10-31-2001

TOWN OF LEXINGTON — BOARD OF PUBLIC WORKS

SEWER DIVISION

Sketch of Service Here

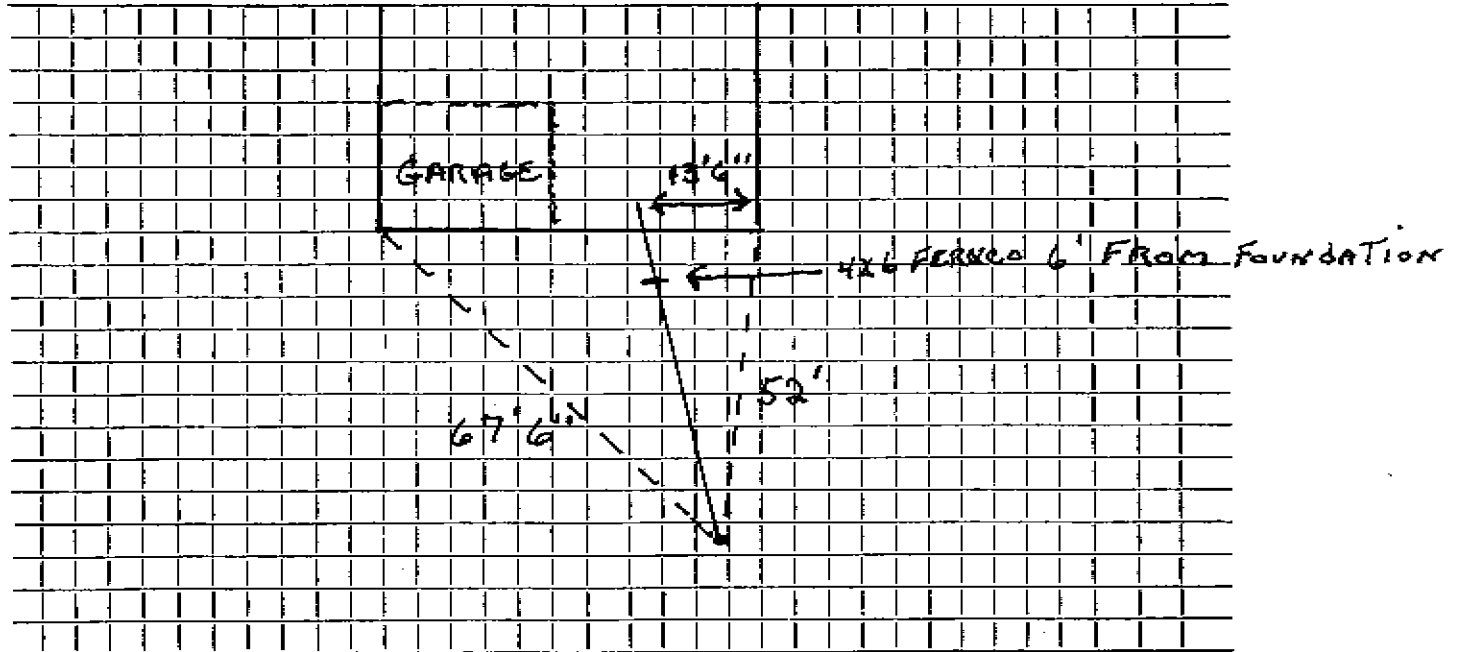

Connection made in ... WARD ... Street. Work completed

Remarks: INSTALLED BY J. McLAUGHLIN