




DATE \_\_\_\_\_

# TOWN OF LEXINGTON — BOARD OF PUBLIC WORKS

## SEWER DIVISION

Sketch of Service Here

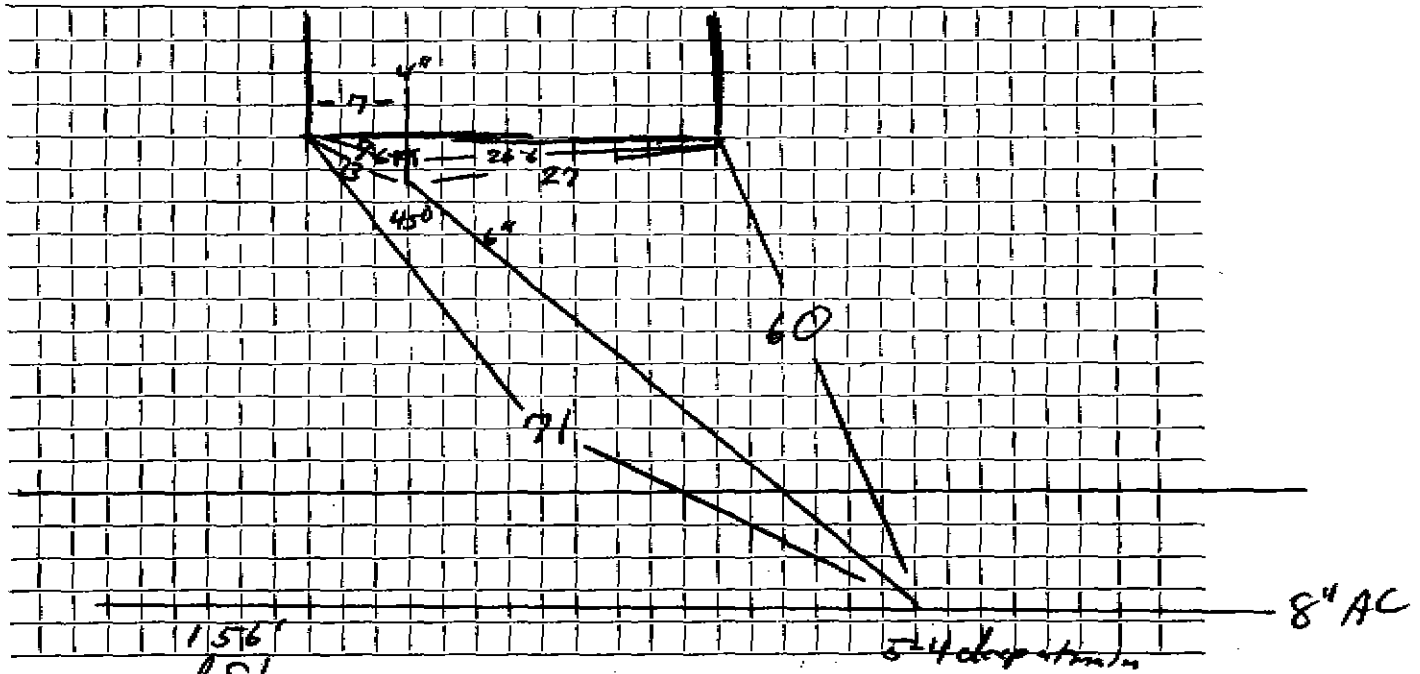

SMH  
①

Connection made in Ward St Street. Work completed \_\_\_\_\_

Remarks: top on side of main

ties from Con. sewerage cannot over, they did not call