

Name Alice M. Ryan

Service No. 71

Address 68 Ward Street

68 Ward Street

Location

Kind of Pipe

Size 6"

Size of Main 8"

~~REPAIR~~ New Service

W.O.# 8763


Location Conn 9-21-64

Date	Material	Amount	Total	Date	Amount
5-15-64	Labor	83.81		4-29-64	29.50
5-16-64	"	8.98	92 79	9-21-64	68.48
	10% O.H.	9 28	102 07		210 52
	1/8" 6" Transite pipe @.82		39 36		
	1 Bag Cement		1 50		
	1 90° Transite Elbow		4 09		
	1 24x6 Service Saddle		7 50		
	15 X 3 Patch		15 00		
	5 Yds Loam @ 3.00		15 00		
	2 Hrs Town Shovel @ 6.50		13 00		
	3 Hrs Trucking @ 3.00		9 00		
	1 Hr Loader @ 4.00		4 00		
			210 52		

DATE _____

TOWN OF LEXINGTON — BOARD OF PUBLIC WORKS
SEWER DIVISION

Sketch of Service Here **68**

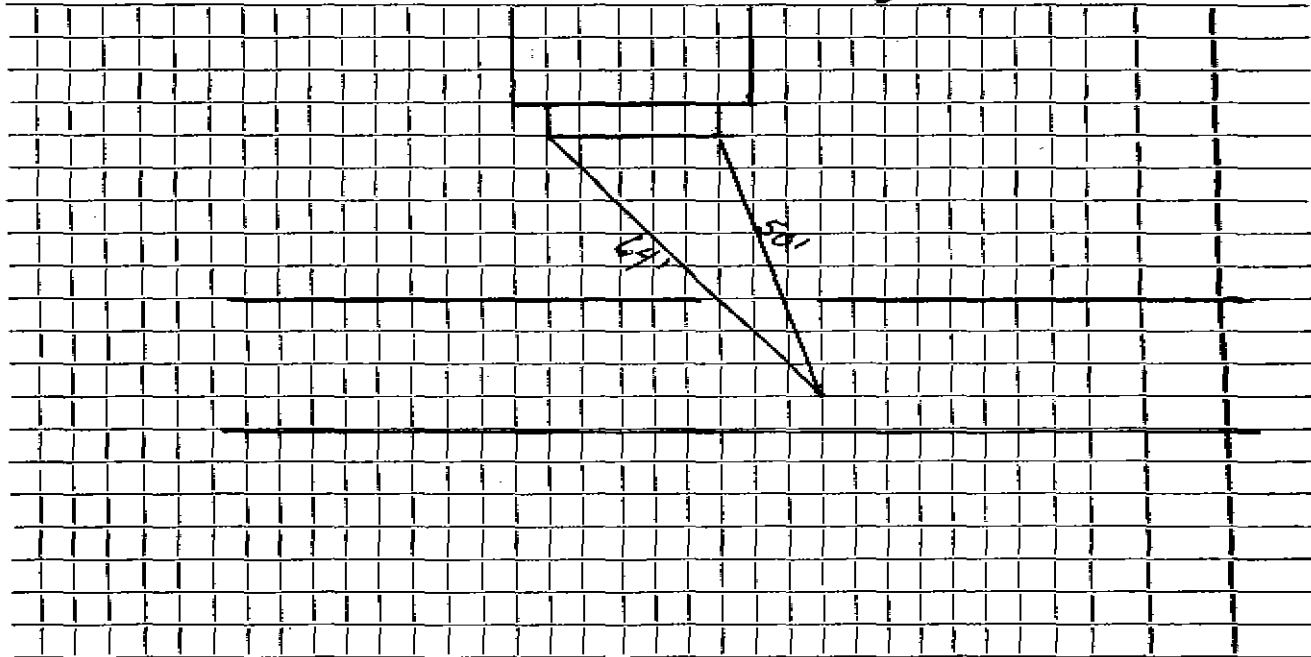

Connection made in Street. Work completed

Remarks:
.....
.....