




TOWN OF LEXINGTON — BOARD OF PUBLIC WORKS

SEWER DIVISION

Sketch of Service Here

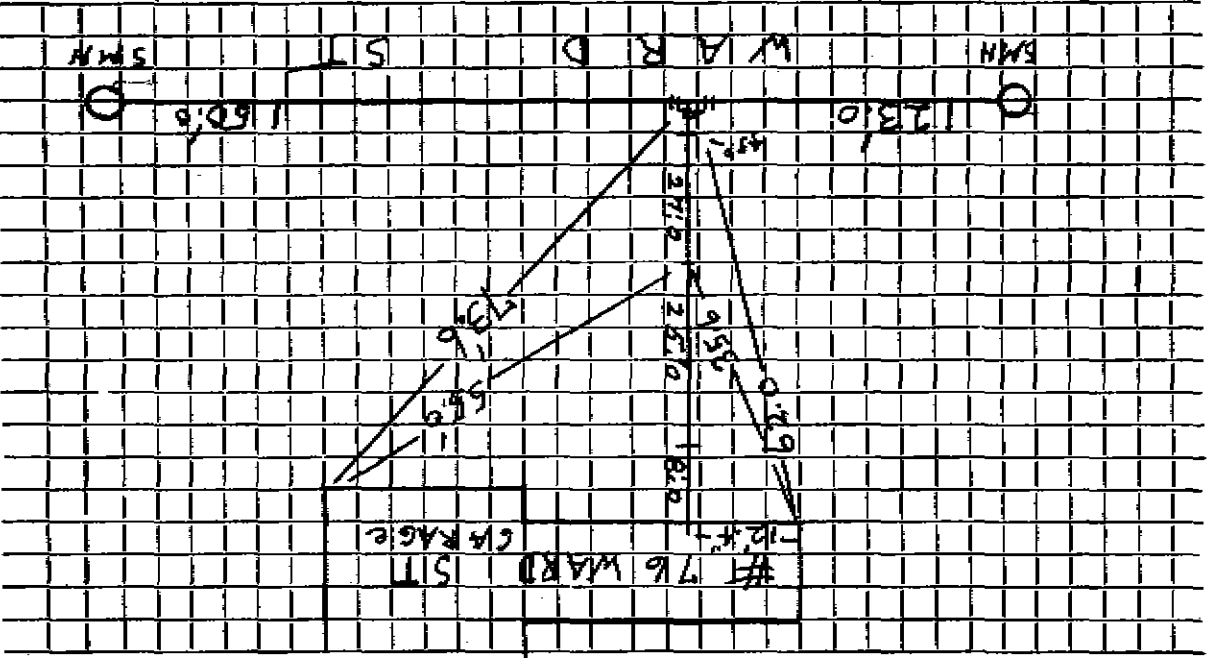

Connection made in Ward 5T Street

Work completed

11/17/05

J McLeschia

Remarks: